

KANSAS


Stafford

FORM 51 5M 10-41 PETROL

Section 27 Township 23 Range 12-W

Well No. #2 Allen "B"

Company Stanolind

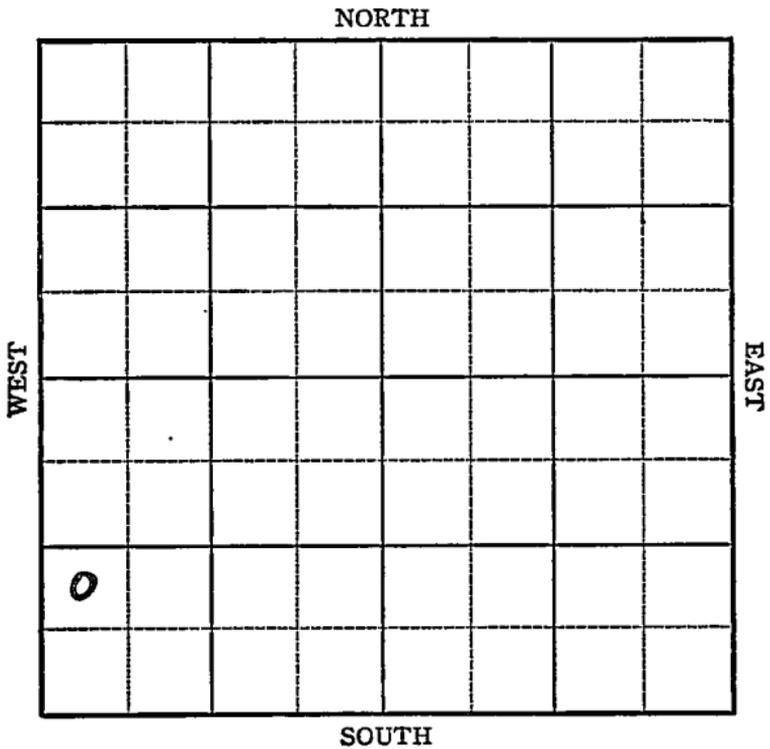

Sec. 27 Twp. 23 R. 12-W

Well No. #2 Allen "B" Farm

Stanolind Company


(Bedford)

 Ft. from N. Line

990 Ft. from S. Line

 Ft. from E. Line

330 Ft. from W. Line

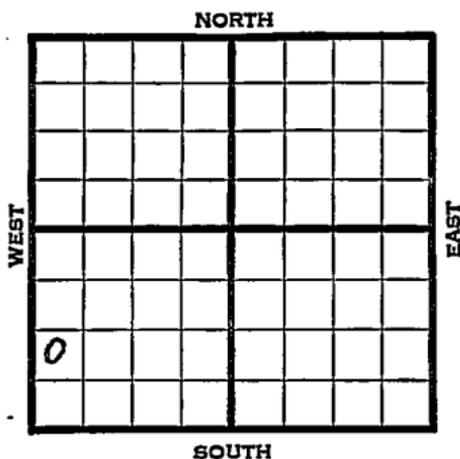

Elev. 1863

REPORT

~~1942~~

5/6 Location

5/13 Derrick.

5/20 8" - 346' Drlg. 2355'

5/27 Simp. 3770' Drlg. 3805'

6/3 Arb. 3840' 5" - 3840'

T.D. 3846' S.O. 500 acid.

6/10 Arb. 3840'

5" - 3840'

T.D. 3846'

1500 acid.

Depthograph potential 1249 oil & 33%
water. 36. Gravity

COMPLETED

Map No. 47 Sec. 27 Twp. 23 R. 12W

Well No. 2 Allen "B"

Stanolind Company

FIRST REPORT

Contractor

NW SW SW

SECTION PLAT

0			

_____ Ft. from N. Line

990 Ft. from S. Line

_____ Ft. from E. Line

330 Ft. from W. Line

BEDFORD POOL

Location XXX

Rig up _____

Drilling and Remarks:

RECORD

Cased _____ in., _____ ft.

Sand _____

Gas _____

Oil _____

Total Depth _____

PRODUCTION

1st 24 hrs. Nat. _____

1st 24 hrs. after shot _____

Gas _____ Cu. Ft.

Dry Hole _____

Abandoned _____

Date

MAY 6 1942 19

S. J. LEWIS

Scout

