



Sec. 27 Twp. 23 R. 12-W

Well No. #1 Meyer Farm

Stanolind Company

(Bedford)


\_\_\_\_\_ Ft. from N. Line

990 Ft. from S. Line

\_\_\_\_\_ Ft. from E. Line

330 Ft. from W. Line

Elev. 1857

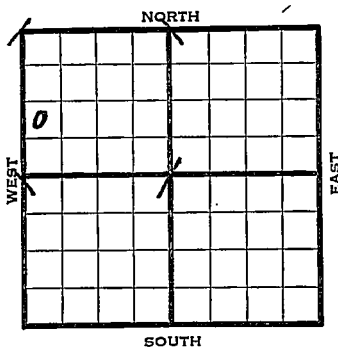

1942

REPORT

3/25

Location

4/2

8" - 375' WOC.

4/8

Drlg. 2926'

4/15

Lans. 3390' Arb. 3818-27' T.D.

Run casing.

4/22

5" - 3818' 1000 acid. Swab 3oil &  
2 water per hour 6 hours.

4/29

T.D. 3838' 5000 acid.

Swab 16 oil per hour 3 hours.

5/6

Arb. 3818'

5" - 3818'

T.D. 3838'

6000 acid.

Depthograph potential 1793 bbls. and  
21% water.

36. Gravity

COMPLETED

Map No. 47 Sec. 27 Twp. 23 R. 12WWell No. 1 MeyerStanolind

Company

**FIRST REPORT**

Contractor

NW SW NW

## SECTION PLAT

|   |  |  |  |
|---|--|--|--|
|   |  |  |  |
| 0 |  |  |  |
|   |  |  |  |
|   |  |  |  |

\_\_\_\_\_ Ft. from N. Line

990 Ft. from S. Line

\_\_\_\_\_ Ft. from E. Line

330 Ft. from W. LineBEDFORD POOLLocation XXX

Rig up \_\_\_\_\_

Drilling and Remarks:

## RECORD

Cased \_\_\_\_\_ in., \_\_\_\_\_ ft.

Sand \_\_\_\_\_

Gas \_\_\_\_\_

Oil \_\_\_\_\_

Total Depth \_\_\_\_\_

## PRODUCTION

1st 24 hrs. Nat. \_\_\_\_\_

1st 24 hrs. after shot \_\_\_\_\_

Gas \_\_\_\_\_ Cu. Ft.

Dry Hole \_\_\_\_\_

Abandoned \_\_\_\_\_

Date

MAR 25 1942

19

S. J. LEWIS

Scout

Stafford **KANSAS**

Map No. 47 Sec. 27 Twp. 23 R. 12W

Well No. 1 Meyer

Stanolind Company

COMPLETED Contractor

**SECTION PLAT**

NW SW NW

\_\_\_\_\_ Ft. from N. Line

990 Ft. from S. Line

\_\_\_\_\_ Ft. from E. Line

330 Ft. from W. Line

|   |  |  |  |
|---|--|--|--|
|   |  |  |  |
| 0 |  |  |  |
|   |  |  |  |
|   |  |  |  |

**BEDFORD POOL**

Location \_\_\_\_\_

Rig up \_\_\_\_\_

Drilling and Remarks:

*Case 3818.*  
*5" @ 3818.*  
*6000 acid*  
*Sept 18 1943*  
*421 1/2 W.*  
*360*

**RECORD**

Cased \_\_\_\_\_ in., \_\_\_\_\_ ft.

Sand \_\_\_\_\_

Gas \_\_\_\_\_

Oil \_\_\_\_\_

Total Depth 3838.

**PRODUCTION**

1st 24 hrs. Nat. \_\_\_\_\_

1st 24 hrs. after shot \_\_\_\_\_

Gas \_\_\_\_\_ Cu. Ft.

Dry Hole \_\_\_\_\_

Abandoned \_\_\_\_\_

Date

MAY 6 1942 19

S. J. LEWIS Scout