


Section 27 Township 23 Range 12W

Well No. #2 Meyer

Company Kiser

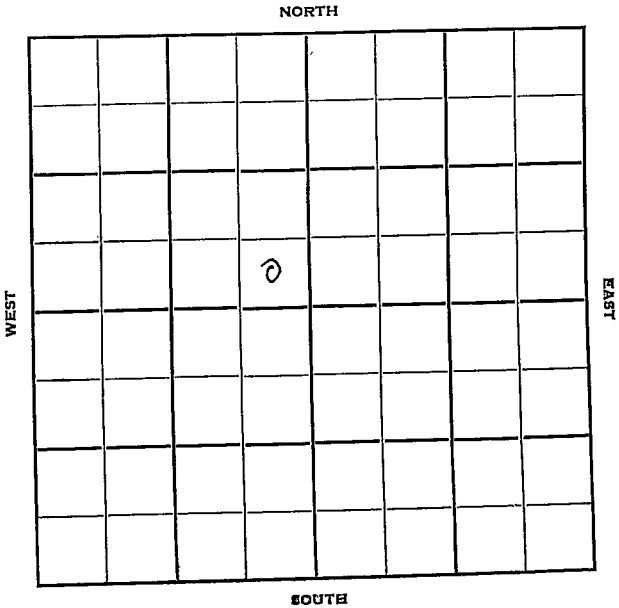

Sec. 27 Twp. 23 R. 12W

Well No. #2 Meyer Farm

Kiser Company

Veeder Supply Contractor
Bedford Pool


Ft. from N. Line

330' Ft. from S. Line

330' Ft. from E. Line

Ft. from W. Line

SE SE NW

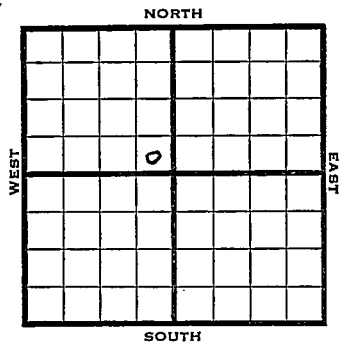

1950

Elev 1861

REPORT

9/13

Spud 9-8-50
Drlg.

10/18

Anhy 660
8" @ 666
Lans 3407
Cong 3699
Simp 3811
TD 3910
D&A

Stain 3443-47
Viola 3734
Arb 3879

ABANDONED

Handwritten mark

