


Section 27 Township 23 Range 12W

Well No. 1 Thole

Company Black-Marshall

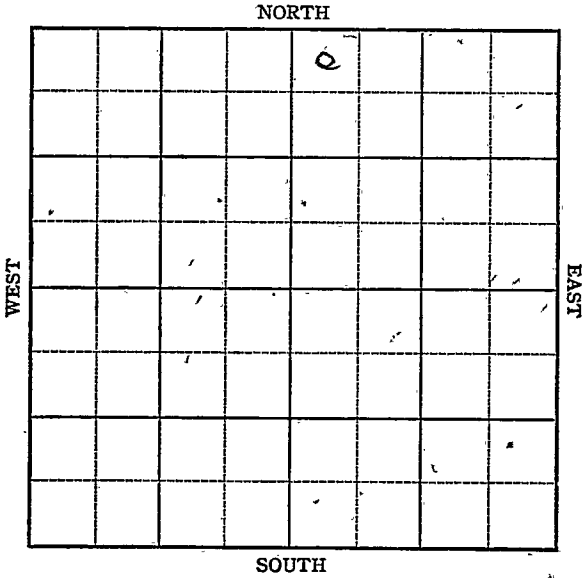

KANSAS

Stafford county

27

23

12W

Sec. _____ Twp. _____ R. _____

1 Thole

Well No. _____ Farm _____

Black-Marshall


Company _____

Brock Pool

NORTH

330

Ft. from N. Line

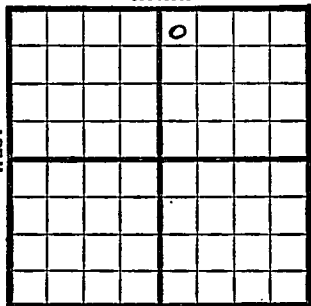

Ft. from S. Line

Ft. from E. Line

330

Ft. from W. Line

NW NE

SOUTH

1947

Elev. 1856' REPORT

5/28

8" @ 280
Drlg. 3410'.

6/4

Lans. 3402'
Arb. 3863'
TD 3875'

ABANDONED

Map No. _____ Sec. 27 Twp. 23 R. 12W

Well No. 1 Thole

Black-Marshall Company

FIRST REPORT Contractor

NW NE

SECTION PLAT

330 Ft. from N. Line

_____ Ft. from S. Line

_____ Ft. from E. Line

330 Ft. from W. Line

		10	

Stafford County

Location _____

Rig up _____

Drilling and Remarks:

8" @ 280
drlg. 3410

RECORD

Cased _____ in., _____ ft.

Sand _____

Gas _____

Oil _____

Total Depth _____

PRODUCTION

1st 24 hrs. Nat. _____

1st 24 hrs. after shot _____

Gas _____ Cu. Ft.

Dry Hole _____

Abandoned _____

Date

MAY 28 1947 19

S. J. LEWIS Scout

Map No. 47 Sec. 27 Twp. 23 R. 12W

Well No. 1 Thole

Black-Mar shall Company

ABANDONED

Contractor

NW NE

E 1, 1886
SECTION PLAT

330 Ft. from N. Line

_____ Ft. from S. Line

_____ Ft. from E. Line

330 Ft. from W. Line

		6	

Stafford County

RECORD

Location _____

Cased _____ in. _____ ft.

Sand _____

Gas _____

Oil _____

Total Depth 2825

Rig up _____

Drilling and Remarks:

Yans 3402

Ar 3843

PRODUCTION

1st 24 hrs. Nat. _____

1st 24 hrs. after shot _____

Gas _____ Cu. Ft.

Dry Hole _____

Abandoned _____

Date / /

JUN 4 1947

S. J. LEWIS Scout