

Stafford


KANSAS

DX 78-1

Section 27 Township 23 Range 13W

Well No. #1 Williams

Company Lee Phillips

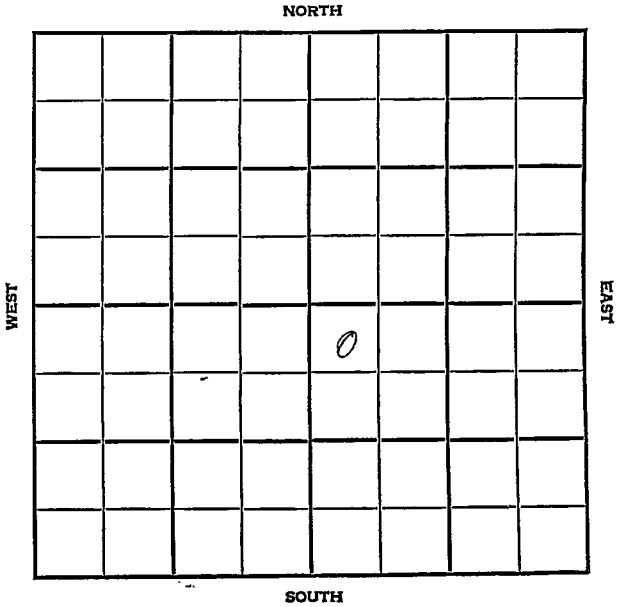

Stafford

KANSAS

SEC.	TWP.	R.
27	23	13 W

WELL NO.

1 Williams

FARM

COMPANY

Lee Phillips

CONTRACTOR

Harms-Burt


St. John Twst

_____ Ft. from N. Line

_____ Ft. from S. Line

_____ Ft. from E. Line

_____ Ft. from W. Line

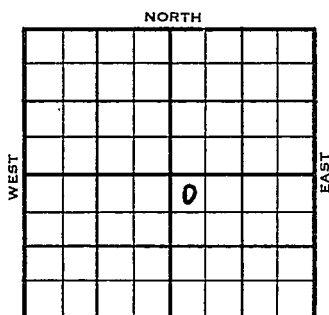

NW NW SE SDX - 1/2 Mile

Stanolind-FO. Sun & Champlin-DHM

	ELEVATION	REPORT
1956	1893'	

5/23

Comm. 5-21-56.

8" @ 294 w/250 WOG

5-31

Stuck @ 2432

6-6

DST 3913-16 op 60 min. rec. 30' MCO /
300' O&GCSW ,BHP 990#.

D & A

H. 3330', BL. 3468', L. 3494',
Cgl. 3810', V. 3818', S. Sh. 3876',
S. sd. 3912', A. 3937'.

TD 3965'.

ABANDONED

County Stafford Elev. _____
 Sec. 27 Twp. 23 Rge. 13W
 Company Lee Phillips
 FarmName Williams No. 1

TOPS	DEPTH	LOG	DATUM
------	-------	-----	-------

Anh.			
TP.			
H.			
Tr.			
Dg.			
Bl.			
L.			
K.C.			
B.K.C.			
Ce.			
C.			
M.			
M.			
K.			
Mz.			
Mq.			
V.			
S.			
S.			
A.			
R.			
PE.			
G.			
T.D.			

Loc. in Sec.

NW NW SE

Geol.

Concr.

Hazms-Burt

Pool

St. John Twst.

1/2 mile
 FIRST REPORT
 MAY 23 '56

Date Comm. 5-21-56 Stanolind - FO
8 1/2 @ 294/250 WOC Sun & Champlin - DHM

SEPT 25 '56

M M

County Stafford Elev. 1893 Co. 1
 Sec. 27 Twp. 23 Rge. 13W
 Company Lee Phillips
 Farm Name Walliams No. 1

	DEPTH	LOG	DATUM	Loc. in Sec.
				NW NW SE
W.	3330	3326		
Tr.				
Dg.				
Bl.	3468	3489		
L.	3484			
K.C.				Geol.
B.K.C.				Contr.
Ce. <u>121</u>	3810			Harms-Burt
C.				
M.				Pool
M.				St. John Twst.
K.				
Mz.				
Ma.				
V.	3818	3814		
S.	3876	3871		
S.	3912	3906		
A.	3937	3934		
R.				
Pe.				
G.				
TD.	3965			

ABANDONED
 JUN 6 1956

Date Comm. 5-21-56 Stanolind & FO Sun & Champlin - DHM

8th, C.294/250 WOC MAY 23 '56 X stuck @

2432 JUN 6 '55 DST 3913-16 (60)

rel 30 MCO + 300 OAGLSW BHP
 990

TD 3965 Log

DIA