


Section 27 Township 23 Range 18W

Well No. 1 W. R. McClaren

Company J. J. Lynn

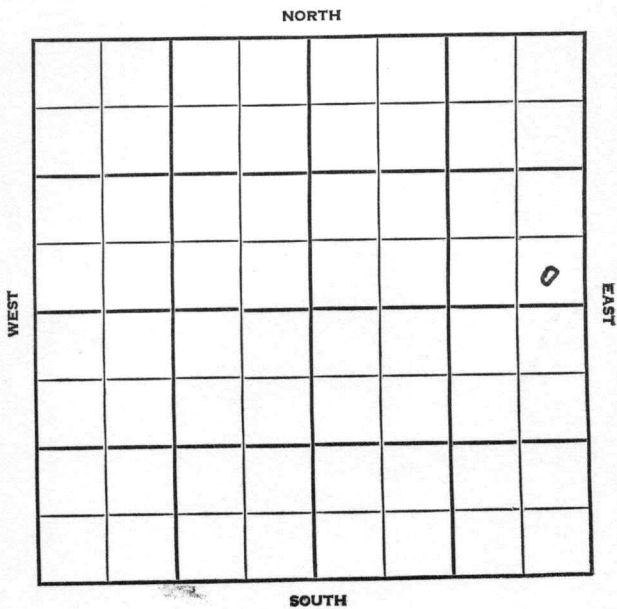

Pawnee

KANSAS


SEC.	TWP.	R.
27	23	18W

WELL NO. #1 W.R. McClaren FARM

COMPANY J.J. Lynn

CONTRACTOR Sterling Drlg.

_____ Ft. from N. Line
 330 _____ Ft. from S. Line
 330 _____ Ft. from E. Line
 _____ Ft. from W. Line

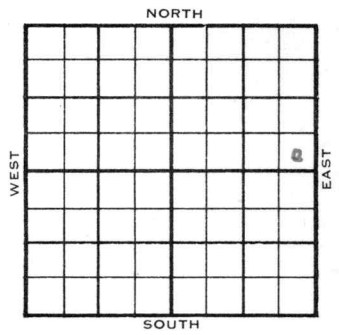

SE SE NE

1954	ELEVATION 2102'	REPORT
------	--------------------	--------

9/1
10/6

Drlg. 2490'

Spud 8-26-54 Temp. adb. TD 4495'
 8-5/8" @ 300 Heeb 3745 Doug. 3776
 Br. lime 3853' KC 3862'
 DST 4016-76 open 1 hr rec 150' G &
 WCM, 1200# Cong 4322 Ch. Cong 4341'
 DST 4372-4400 open 1/2 hr rec 7' drlg. m
 mud. # Miss 4417' DST 4405-4425',
 open 1 hr rec 120' GCM 670#
 DST 4418-47 open 1 hr rec 480' gas,
 270' HO & GCM, 120' SW 1320#
 TD 4495 5" @ 4494
 Schl tops: Heeb 3745 Doug 3775
 Br lime 3854 Lans 3862 Cong 4322
 Ch Cong 4341 Miss 4417 Miss lm 4480
 CO to 4459 60/4417-26 B/1/2 GO 18 GWPH
 Hydrofrac S/15 BF 99% wtr. CO to
 4432' 60/4422-32 frac 17 GWPH
 1 BO Temp. abd.

ABANDONED

Drig. Data

S/ 15 bf 99% wtr. 60 to 4432

60/ 4422-32 frac 17 gwph 1 bo

Temp. abd.

OCT 19 1954

