


Section 27 Township 23 Range 34-W

Well No. #1 Garden City "G"

Company Cities Service
Hugoton Pool

NORTH

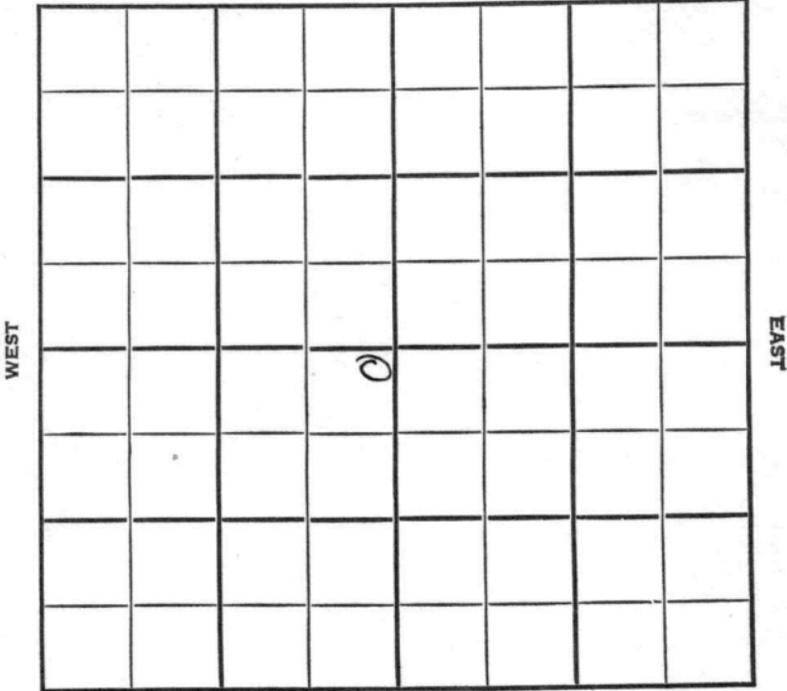

SOUTH

KANSAS

Finney

Sec. 27 Twp. 23 R. 34W

Well No. #1 Garden City "G" Farm

Cities Service Company

Hugoton Pool


100' Ft. from N. Line

_____ Ft. from S. Line

100' Ft. from E. Line

_____ Ft. from W. Line

NE SW

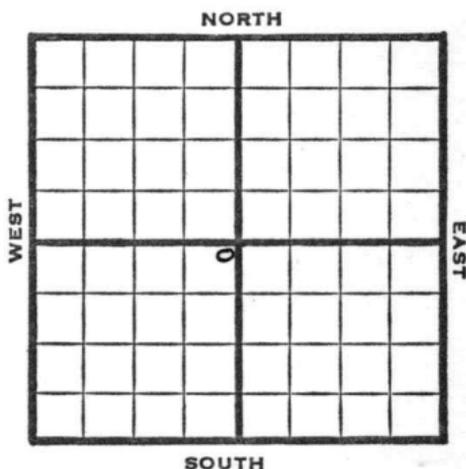

1948

Eli 2964'

REPORT

6/16	8" @ 760'
	Drilg. 1610'
6 23	TD 2690'
	5" @ 2689'
6/29	100 shots 2540-60
7/8	40 shots 2500-18
	50 shots 2480-90'
	90 shots 2454-62 total 165,00 acid
7/14	9000 acid
7/21	TD 2690'
	5" @ 2689'
	Perff 25500 acid
	2,890,000 Gas
	399# R Pr.
	Comp.

COMPLETED

Map No. _____ Sec. 27 Twp. 23 R. 34W

Well No. 1 Garden City "G"

Cities Service

Company

FIRST REPORT

Contractor

NE SW

SECTION PLAT

100 Ft. from N. Line

_____ Ft. from S. Line

100 Ft. from E. Line

_____ Ft. from W. Line

	6		

Finney County

RECORD

Location _____

Cased _____ in., _____ ft.

Rig up _____

Sand _____

Drilling and Remarks:

Gas _____

8" @ 760

Oil _____

drlg. 1610

Total Depth _____

PRODUCTION

1st 24 hrs. Nat. _____

1st 24 hrs. after shot _____

Gas _____ Cu. Ft.

Dry Hole _____

Abandoned _____

Date

JUN 16 1948

19 _____

S. J. LEWIS

Scout

Map No. _____ Sec. 27 Twp. 23 R. 34W

Well No. 1 Garden City "G"

Cities Service Company

COMPLETE

Contractor

NE SW

E/2964

SECTION PLAT

100 Ft. from N. Line

_____ Ft. from S. Line

100 Ft. from E. Line

_____ Ft. from W. Line

	o		

Finney County

RECORD

Location _____

Cased _____ in., _____ ft.

Rig up _____

Sand _____

Drilling and Remarks:

Gas _____

5" 02689

Oil _____

Perf.

Total Depth 2690

25300 acid

PRODUCTION

2,890,000 Gas

1st 24 hrs. Nat. _____

1st 24 hrs. after shot _____

Gas _____ Cu. Ft.

Dry Hole _____

Abandoned _____

*399 * R/B*

Date

JUL 21 1948

19

S. J. LEWIS

Scout