


Section 27 Township 23 Range 35WWell No. #1 SteenisCompany Cities Service & MCPC
Hugoton Pool

NORTH

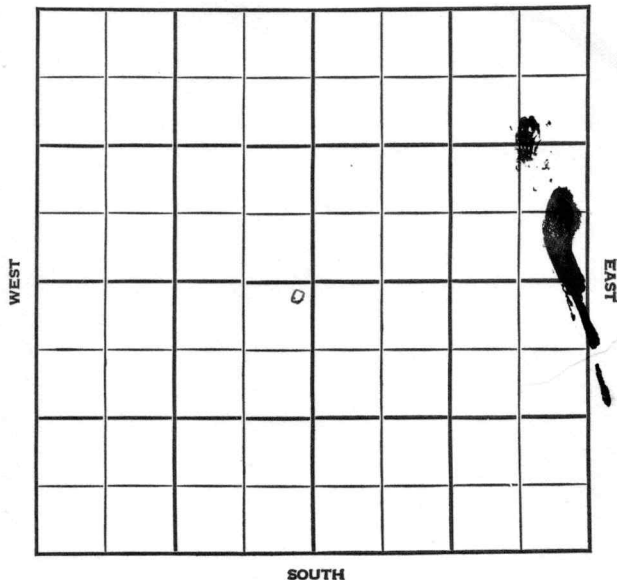

Sec. 27 Twp. 23 R. 35WWell No. #1 Steenis FarmCities Service & MCPC- $\frac{1}{8}$ Company

Houghton Pool


100' Ft. from N. Line

Ft. from S. Line

100' Ft. from E. Line

Ft. from W. Line

NE SW

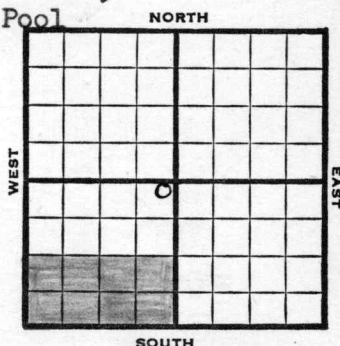

1948

REPORT

Est. Elevation 3016'

4/21 8" @ 760'

WOC

4/23 Drilling 1630'

(C.S)

4/26 T.D. 2700'

5 $\frac{1}{2}$ " set 2699' w/700 sacks.

WOC

(C.S)

4/27 MICT

(P.R)

4/28 WOC

4/28 "

"

4/30 "

"

5/3 " MI unit.

"

5/3 Top cmt. 2665'

Perf. 2622-36' w/70 shots. no gas, wtr.

Acid 2622-36' with 1000 gals. 15% acid

(S-S)

5/4 Flowing 416 MCF 24 hrs. after acid.

Acid 2622-36' w/2500 gals. 15% acid

5000 gals. wtr. Press. 100-0#

(C-S)

5/5 Blowing 439 MCF 24 hrs. after acid

TD 2700' PTD 2665'

"

5/6 Blowing 439 MCF gas 48 hrs. after acid.

"

5/7 Blowing 439 MCF 72 hrs. after acid.

Perf. 2552-80' w/140 shots no increase

2518-34' w/80 shots no incr.

2500-14' w/70 shots no inc.

No wtr.

"

OVER

1948

5/10

OTD 2700'

T.D. 2665'

Blowing 439 MCF 72 hrs after acid.

Perf. 2552'-80' w/140 shots.

No increase.

2518'-34' w/80 shots; no increase.

2500'-14' w/70 shots; no increase;
no water.

Herington 2469' Ft. Riley 2616'

Krider 2500'

Windfield 2554'

70 shots 2622-36 - 1000 acid (P.R.)

5/11

Testing 2665'

"

5/12

Testing NR. Est.

"

5/13

Blowing 1240 mcf 48 hrs. after acid.

Acid. all pays together w/9000 gals.

5% acid, 12,000 water. 44 mins.

Press. 250-0#

Blowing 1180 mcf 24 hrs. after acid."

5/14

Testing

5/17

"

5/18

"

"

5/19

"

"

5/21

Shut in.

5/24

Testing.

"

5/26

Testing TD 2665'

"

5/27

Shut in for 72 hour test.

"

5/28

OTD 2700'

Shut in for 72 hr. gauge.

T.D. 2665'

(P R)

6/1

OTD 2700'

Taking 72 hr. test. NR

"

6/2

" " " " "

"

6/2

Comp. for 20 mins.

Open flow of 5,780 MCF.

No water.

72 hr. shut in press. 421.8#.

(Cities Service)

6/3

Comp 6-1-48

5,870,000 cu. ft. gas per day on

20 min. open flow.

Pressure 421.8#.

(P R)

6/9

5 $\frac{1}{2}$ " @ 2699' Perf. 29000 acid

5,870,000 Gas 422# R. Pr.

TD 2700'

Comp.

COMPLETED

Map No. _____ Sec. 27 Twp. 23 R. 35W

Well No. 1 Steenis

Cities Service + M.C.P.C. Company

FIRST REPORT

Contractor

NE SW


SECTION PLAT

100 Ft. from N. Line

_____ Ft. from S. Line

100 Ft. from E. Line

_____ Ft. from W. Line

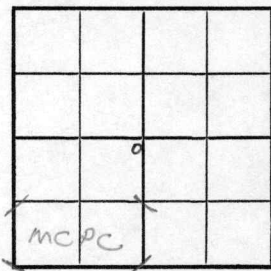

Kearny County

Location _____

Rig up _____

Drilling and Remarks:

8" @ 760 WOC

RECORD

Cased _____ in., _____ ft.

Sand _____

Gas _____

Oil _____

Total Depth _____

PRODUCTION

1st 24 hrs. Nat. _____

1st 24 hrs. after shot _____

Gas _____ Cu. Ft.

Dry Hole _____

Abandoned _____

Date

APR 21 1948

19

S. J. LEWIS

Scout

Map No. _____ Sec. 27 Twp. 23 R. 35WWell No. 1 Steenis Unit

_____ Cities Service etal. _____ Company

COMPLETE

Contractor

NE SW

E13016

SECTION PLAT

100 Ft. from N. Line

_____ Ft. from S. Line

100 Ft. from E. Line

_____ Ft. from W. Line

	4		

Kearny County

Location _____

Rig up _____

Drilling and Remarks:

5 1/2 " @ 2688Prof.29000 acid\$1,870,000 Gas422 * R P

RECORD

Cased _____ in., _____ ft.

Sand _____

Gas _____

Oil _____

Total Depth 2700

PRODUCTION

1st 24 hrs. Nat. _____

1st 24 hrs. after shot _____

Gas _____ Cu. Ft.

Dry Hole _____

Abandoned _____

Date

JUN 9 1948 19 _____S. J. LEWIS Scout