


Section 27 Township 23 Range 37 W

Well No. # 1 Sauer

Company Kansas-Nebraska

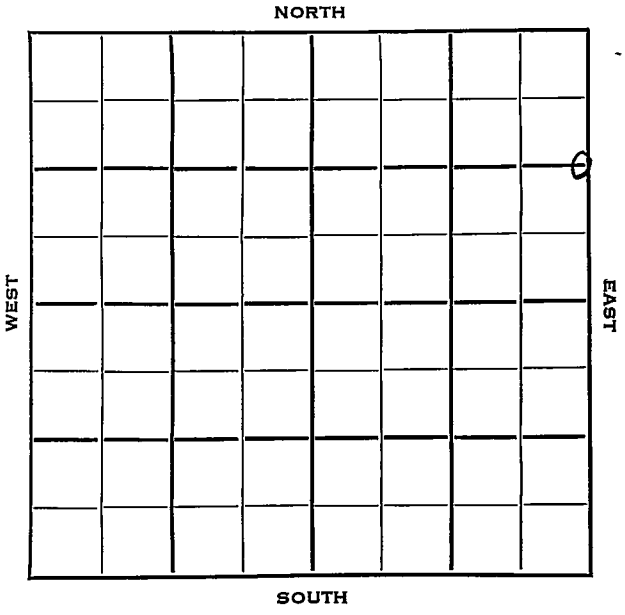

Kearny KANSAS

SEC.	TWP.	R.
27	23	37W ✓

WELL NO. \_\_\_\_\_

1 Sauer \_\_\_\_\_ FARM

COMPANY \_\_\_\_\_

Kansas-Nebraska

CONTRACTOR \_\_\_\_\_


Honaker Drlg.

1320 \_\_\_\_\_ Ft. from N. Line

\_\_\_\_\_ Ft. from S. Line

150 \_\_\_\_\_ Ft. from E. Line

\_\_\_\_\_ Ft. from W. Line

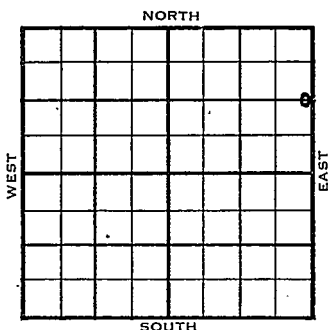

C E/2 E/2 NE

1954

ELEVATION  
3263'

REPORT

3/31

Spud 3-26-54  
8" @ 335'  
Drlg. 2170'

4/7

Her 2541', Kr. 2550', Win 2598'  
Tow 2640', Ft. Riley 2690'  
TD 2756'  
5" @ 2752'

5/5

WOCT.

5/26

Spud 3-26-54  
Gas well TD 2756 8" @ 335 Her. 2541  
2541 Kri. 2550' Win. 2598 Tow. 2640  
Ft. Riley 2690' TD 2756 5" @ 2752  
CO to 2741 72/2696-2708 1000 A  
PB 2676 132/2640-62 144/2592-2616  
138/2541-64 frac.  
Comp. 7,850,000 gas.

**COMPLETED**



