



Reno

Map No. KANSAS Sec. 28 Twp. 23 R. 7W

Well No. 1 - Davies Farm  
Anderson & Kew etc Company


NORTH

330 Ft. from N. Line

\_\_\_\_\_ Ft. from S. Line

330 Ft. from E. Line

\_\_\_\_\_ Ft. from W. Line

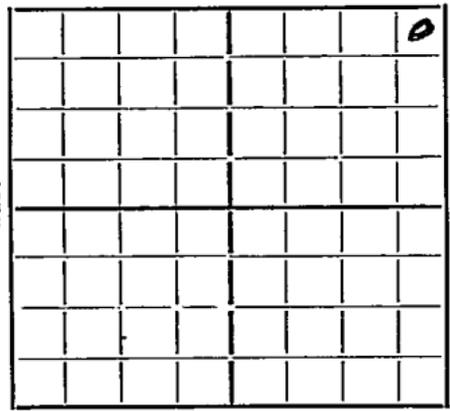

Elev. 1604

Date 1935

REPORT

7/2 Moving Rotary  
7/14 Bly 760 12" 250  
7/18 " 2100  
8/7 Top Siliceous 4095  
 T.D. 4119  
 D. + a. 4119

ABANDONED

Map No. 41 Sec. 28 Twp. 23 R. 7W

Well No. 1 - Davies

Anderson-Kerr et al Company

..... Contractor

**FIRST REPORTS**

**SECTION PLAT**

330 Ft. from N. Line

..... Ft. from S. Line

330 Ft. from E. Line

..... Ft. from W. Line

			0

Location.....

Rig up.....

Drilling and Remarks:

*Moving  
Potary*

**RECORD**

Cased..... in., ..... ft.

Sand.....

Gas.....

Oil.....

Total Depth.....

**PRODUCTION**

1st 24 hrs. Nat.....

1st 24 hrs. after shot.....

Gas..... Cu. Ft.

Dry Hole.....

Abandoned.....

Date

7-7-33

**ORVAL MANNSCHRECK**

192.....

Scout

Map No. 41 Sec. 28 Twp. 23 R. 7W

Well No. 1-Davies

Anderson-Kerr et al Company

Contractor

ABANDONED

SECTION PLAT

330 Ft. from N. Line

..... Ft. from S. Line

330 Ft. from E. Line

..... Ft. from W. Line

			0

Location.....

Rig up.....

Drilling and Remarks:

NO + #

RECORD

Cased..... in., ..... ft.

Sand Sil 4095

Gas.....

Oil.....

Total Depth 4119

PRODUCTION

1st 24 hrs. Nat.....

1st 24 hrs. after shot.....

Gas..... Cu. Ft.

Dry Hole.....

Abandoned.....

Date

8-7-35 192.....

ORVAL MANNSCHECK

Scout