

KANSAS

Reno

FORM 51 5M 4-41 PETROL

Section 28 Township 23 Range 10-W

Well No. 1 Kreie "E"

Company Cities Service Oil

NORTH Peace Creek Pool

		0					

3

WEST

EAST

SOUTH

Sec. 28 Twp. 23 R. 10-W

Well No. #1 Kreie "E" Farm

Cities Service Oil Company

(Peace Creek)


990 Ft. from N. Line

 Ft. from S. Line

990 Ft. from E. Line

 Ft. from W. Line

Elev. 1782

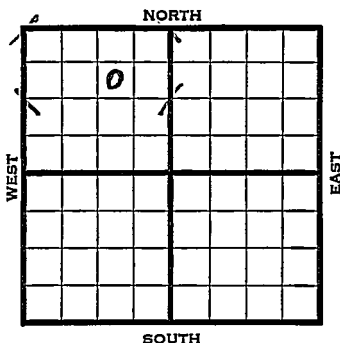


1942	REPORT
4/22	Rotary.
4/29	8" - 233' Drlg. 2328'
5/6	Viola ³⁷⁸¹ 3785 T.D. 3785'
	5" - ³⁷⁸² 3784 RUST.
5/13	" " "
5/20	Kind. 3661' Viola 3781' (Corrected)
	5" - 3782' T.D. 3790' 500 acid.
	Fill up 100' oil per hour.
5/27	" " " "
6/3	Viola 3781'
	5" - 3782'
	T.D. 3790'
	1000 acid.
	Pump 132 oil & 75 water.
	42. Gravity
	COMPLETED

Map No. 47 Sec. 28 Twp. 23 R. 10WWell No. 1 Kreie "E"Cities Service Oil CompanyFIRST REPORT Contractor

SW NE NW

990 Ft. from N. Line Ft. from S. Line990 Ft. from E. Line Ft. from W. Line

SECTION PLAT

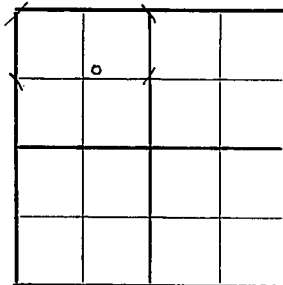PEACE CREEK POOLLocation Rig up

Drilling and Remarks:

Rotary

RECORD

Cased in., ft.Sand Gas Oil Total Depth

PRODUCTION

1st 24 hrs. Nat. 1st 24 hrs. after shot Gas Cu. Ft.Dry Hole Abandoned

Date

APR 22 1942 19 S. J. LEWIS Scout

Reno

KANSAS

Map No. 47 Sec. 28 Twp. 23 R. 10WWell No. 1 Kreie "E"Cities Service Oil

Company

COMPLETED

Contractor

SW NE NW

SECTION PLAT

	6		

990 Ft. from N. Line Ft. from S. Line990 Ft. from E. Line Ft. from W. Line

PEACE CREEK POOL

Location Rig up

Drilling and Remarks:

*Vista 3781**5" @ 3782**1000 acid**Pump 132 oil +**78 Water P & X**420 Gr*

RECORD

Cased in., ft.Sand Gas Oil Total Depth 3790

PRODUCTION

1st 24 hrs. Nat. 1st 24 hrs. after shot Gas Cu. Ft.Dry Hole Abandoned

Date

JUN 3 1942 19

S. J. LEWIS Scout