

# KANSAS

Form 51-5M-7-40-Palace


Stafford

Section 28 Township 23 Range 11-W

Well No. #1 Riley

Company Shell & Atlantic

NORTH Richardson Pool

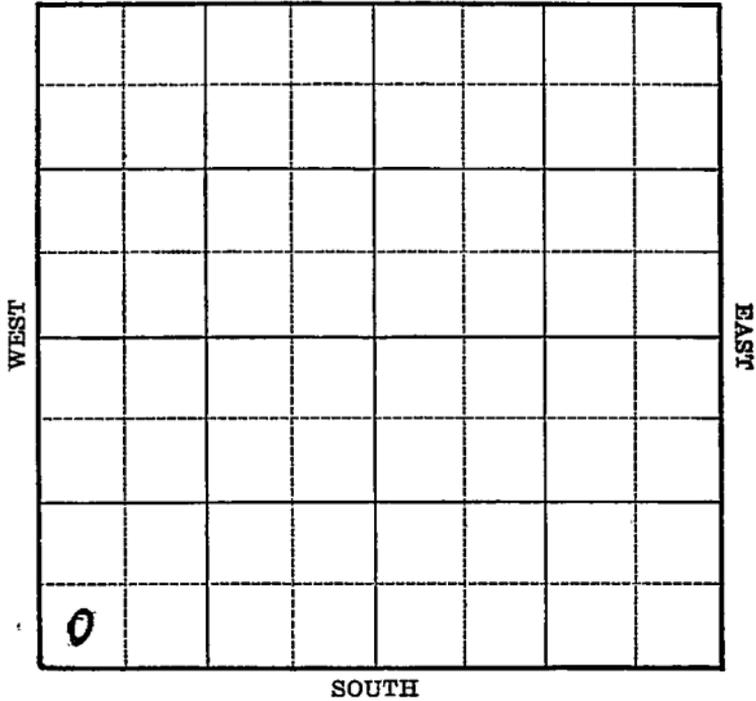

Sec. 28 Twp. 23 R. 11-W

Well No. #1 Riley Farm

Shell & Atlantic Company

(Richardson)


\_\_\_\_\_ Ft. from N. Line

330 Ft. from S. Line

\_\_\_\_\_ Ft. from E. Line

330 Ft. from W. Line

Elev. 1827

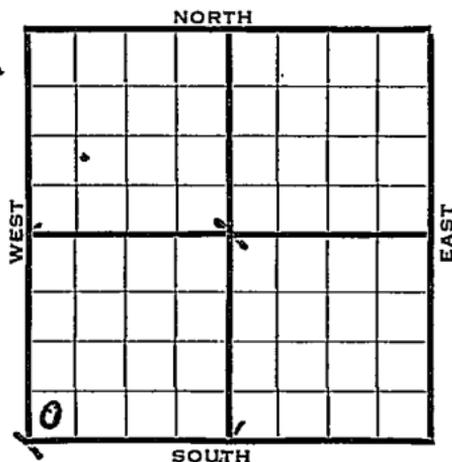

1940	REPORT
7/31	8" - 262'
	Drlg. 1415'
8/8	Anhy 558' Ft. Riley 1760'
	Florence 1855' Drlg. 2865'
8/14	Topeka 2858
	Lansing 3323
	Viola <del>3748</del> <sup>3648</sup> (correction 1/16/41) Lewis
	Core 3767-58½ stain
8/20	Top Arbuckle <del>3754</del> <sup>3762</sup> Coring 3760
	No shows (Tel)
8/22	Arb. 3762-72' T.D. No shows.
	4" - 3762' RUST.
8/26	Drilled plug & C O to bottom
	2900' sulphur water 1 hour
	PB 3704 & perf. 58 shots 3660-90 no sho
	PB 3645 & perf. 36 shots 3471-76
	Filled up 660' oil 1/4 hour, 1120' oil
	1/2 hour, 2300' 1¼ hour, 2990' 3½ hrs.
	Ran bailer No water Flow by heads
	82 bbls. 8 hrs. 29 Grav. at 99
	Testing (Tel)

OVER

1940

8/29--Flowed 82 bbls. 8 hrs. & stopped flowing  
from perforations 3471-76  
Swabbed 153 bbls. 10 hrs. off bottom  
Shot 36 shots 3483-93  
Swab 74 bbls. 2 hrs.  
Last hour swab 18 bbls. off bottom  
Shot 36 shots 3451-61  
Swab 53 bbls. 3 hrs. off bottom  
Cutting 4% BS & Water  
Grav. 29 at 99 Water bringing gravity  
down (Tel)

9/5 6000 acid. Flow 183 bbls. 6 hrs.

9/12 " " " " " "

9/18 Arb. 3762'  
4" - 3762'  
T.D. 3772'  
P.B. to 3645' in Viola  
108 shots 3451-93'  
6000 acid.  
Bomb potential 1677 bbls, 20%  
BS & water.  
Maximum 1342 bbls.  
Top Viola Corrected 1/16/41 to 3648  
**COMPLETED** (Scout Lewis)

Map No. 47 Sec. 28 Twp. 23 R. 11W

Well No. 1 Riley

Shell & Atlantic Company

Contractor

**FIRST REPORT**

SW/C

\_\_\_\_\_ Ft. from N. Line


330 Ft. from S. Line

\_\_\_\_\_ Ft. from E. Line

330 Ft. from W. Line

**RICHARDSON POOL**

**SECTION PLAT**

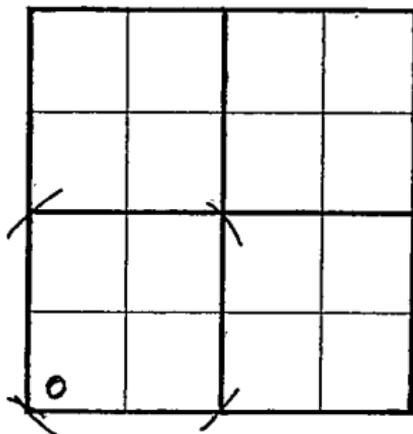

Location \_\_\_\_\_

Rig up \_\_\_\_\_

Drilling and Remarks:

**8" 262**

**Drlg. 1415**

**RECORD**

Cased \_\_\_\_\_ in., \_\_\_\_\_ ft.

Sand \_\_\_\_\_

Gas \_\_\_\_\_

Oil \_\_\_\_\_

Total Depth \_\_\_\_\_

**PRODUCTION**

1st 24 hrs. Nat. \_\_\_\_\_

1st 24 hrs. after shot \_\_\_\_\_

Gas \_\_\_\_\_ Cu. Ft.

Dry Hole \_\_\_\_\_

Abandoned \_\_\_\_\_

Date

III 31 1940 19

S. J. LEWIS Scout

Map No. 47 Sec. 28 Twp. 23 R. 11W

Well No. 1 Riley

Shell & Atlantic Company

Contractor

**COMPLETED**

**SECTION PLAT**

SW/C


\_\_\_\_\_ Ft. from N. Line

330 Ft. from S. Line

\_\_\_\_\_ Ft. from E. Line

330 Ft. from W. Line

**RICHARDSON POOL**  
*Correction*

*1/16/41*

Top Viola 3648  
Location \_\_\_\_\_

**RECORD**

Cased \_\_\_\_\_ in., \_\_\_\_\_ ft.

Sand \_\_\_\_\_

Gas \_\_\_\_\_

Oil \_\_\_\_\_

Total Depth 3772

Rig up \_\_\_\_\_

Drilling and Remarks:

*See 83762*

*4" @ 3762.*

*P.B 3645 in Viola*

*108 skt 8. 3451-93*

*6000 acid*

*Bom & P 7 1677*

*257 B.S.W.*

**PRODUCTION**

1st 24 hrs. Nat. \_\_\_\_\_

1st 24 hrs. after shot \_\_\_\_\_

Gas \_\_\_\_\_ Cu. Ft.

Dry Hole \_\_\_\_\_

Abandoned \_\_\_\_\_

*May 1942*

Date

SEP 18 1940 19

S. J. LEWIS Scout