

KANSAS

FORM 51 5M 4-41 PETROL

Stafford

Section 28 Township 23 Range 12W

Well No. 1 Gerdes

Company Texas

NORTH

		0					

SOUTH

WEST

EAST


//

KANSAS

Stafford

Sec. 28 Twp. 23 R. 12-WWell No. #1 Gerdes FarmTexas Company
(Bedford)330 Ft. from N. Line Ft. from S. Line990 Ft. from E. Line Ft. from W. Line

Elev. 1863

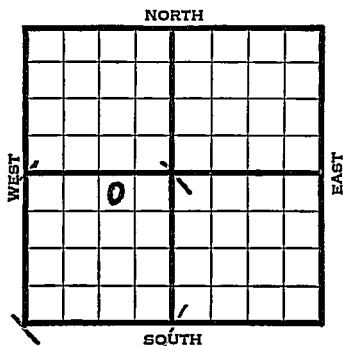

1941

REPORT

6/4 Derrick.

6/12 10" - 343' Drlg. 1145'

6/19 Drlg. 3372'

6/26 Simp. 3785' Arb. 3848-51' T.D.
5" - 3848' RUST.7/3 48 shots 3832-48' 500 acid.
Pump 15 oil per hour.

7/9 Arb. 3848'

5" - 3848'

Lans. 3414'

T.D. 3850'

48 shots 3832-48'

Echometer potential 4105 bbls.

Maximum 3000 bbls.

42. Gravity

COMPLETED

Map No. 47 Sec. 28 Twp. 23 R. 12WWell No. 1 GerdesTexas

Company _____

Contractor _____

FIRST REPORT


NW NE SW

330 Ft. from N. Line

_____ Ft. from S. Line

990 Ft. from E. Line

_____ Ft. from W. Line

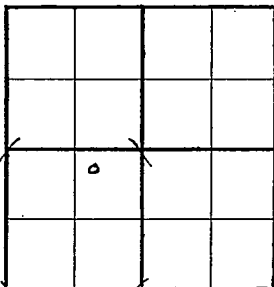BEDFORD POOL**SECTION PLAT**

Location _____

Rig up _____

Drilling and Remarks:

Derrick**RECORD**

Cased _____ in., _____ ft.

Sand _____

Gas _____

Oil _____

Total Depth _____

PRODUCTION

1st 24 hrs. Nat. _____

1st 24 hrs. after shot _____

Gas _____ Cu. Ft.

Dry Hole _____

Abandoned _____

Date

JUN 4 1941 19S. J. LEWIS Scout

Map No. 47 Sec. 28 Twp. 23 R. 12WWell No. 1 GerdesTexas

Company

COMPLETED

Contractor

NW NE SW

330 Ft. from N. Line

Ft. from S. Line

990 Ft. from E. Line

Ft. from W. Line

BEDFORD POOL

SECTION PLAT

	0		

Location

Rig up

Drilling and Remarks:

CR 43848.5" @ 3848.Leans 341445 Shot 3832-48.Eclw 4185Max 3000420 H

RECORD

Cased _____ in., _____ ft.

Sand _____

Gas _____

Oil _____

Total Depth 3850

PRODUCTION

1st 24 hrs. Nat. _____

1st 24 hrs. after shot _____

Gas _____ Cu. Ft.

Dry Hole _____

Abandoned _____

Date

JUL 9 1941

19

S. J. LEWIS Scout