

KANSAS

FORM 51 5M 4-41 PETROL

Stafford

Section 28 Township 23 Range 12-W

Well No. 2 Gerdes

Company Texas

NORTH

WEST

EAST

SOUTH

0

11

KANSAS.

Stafford

Sec. 28 Twp. 23 R. 12-WWell No. #2 Gerdes FarmTexas

Company

(Bredford)


990 Ft. from N. Line

Ft. from S. Line

330 Ft. from E. Line

Ft. from W. Line

Elev. 1866

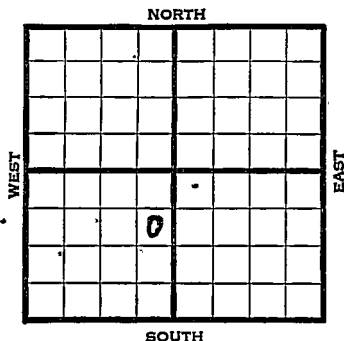

1941

REPORT

7/9

Location

7/17

10" - 222' Drlg. 1325'

7/24

Drlg. 3340'

7/31

Coring 3830'

8/7

Lansing 3430' Arb 3853'

5" @ 3854' TD 3858' 500 acid

1200' oil 8 hrs.


OVER

OVER

1941

8/13

Lans. 3430:

Arb. 3853-55

5" - 3454:

500 acid

T.D. 3858:

Deptho. pot. 1764 oil - no water

Grav. 41.6

COMPLETED

Map No. 47 Sec. 28 Twp. 23 R. 12WWell No. 2 GerdesTexas

Company

Contractor

FIRST REPORT

SE NE SW

990 Ft. from N. Line Ft. from S. Line330 Ft. from E. Line Ft. from W. Line

BREDFORD POOL

SECTION PLAT

Location XRig up

Drilling and Remarks:

RECORD

Cased in., ft.Sand Gas Oil Total Depth

PRODUCTION

1st 24 hrs. Nat. 1st 24 hrs. after shot Gas Cu. Ft.Dry Hole Abandoned

Date

JUL 9 1941

19

S. J. LEWIS Scout

Map No. 47 Sec. 28 Twp. 23 R. 12WWell No. 2 Gerdes

Texas

Company

Contractor

SECTION PLAT

SE NE SW
990 Ft. from N. Line

Ft. from S. Line

330 Ft. from E. Line

Ft. from W. Line

BREDFORD POOL

	0		

Location

Rig up

Drilling and Remarks:

1. am 3430
 Carb 3853-55
 5th 3454
 500 acid
 Depth Pat. 1761 oil
 now

COMPLETED

RECORD

Cased in, ft.

Sand

Gas

Oil

Total Depth 3858

PRODUCTION

1st 24 hrs. Nat.

1st 24 hrs. after shot

Gas Cu. Ft.

Dry Hole

Abandoned

Date

AUG 13 1941

19

S. J. LEWIS

Scout