


KANSAS

FORM 51 25M 3-49 PETROL

Section 28 Township 23 Range 12-W

Well No. #4 Gerdes

Company Texas Co

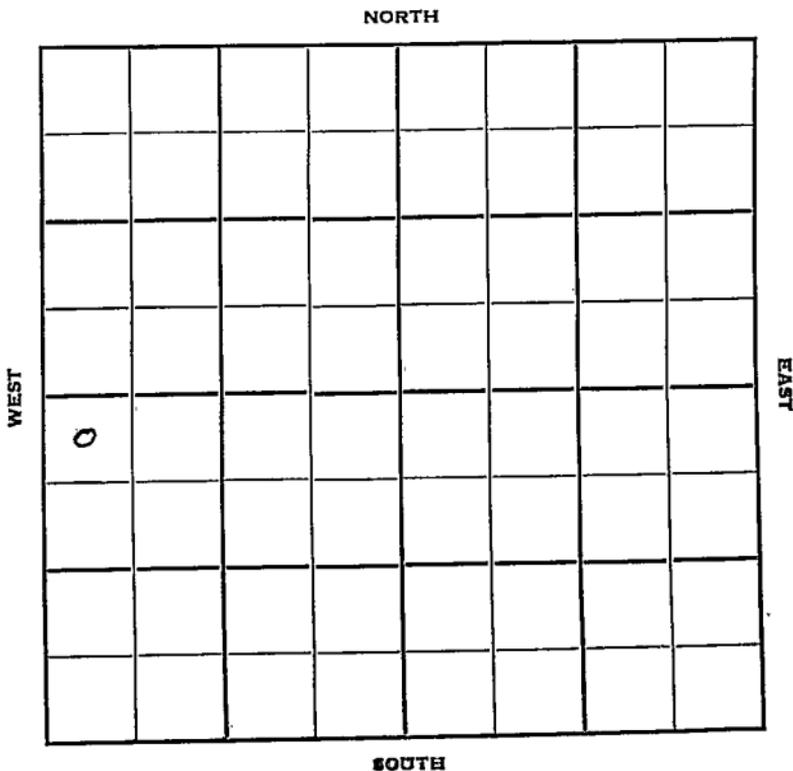

Sec. 28 Twp. 23 R. 12W

Well No. #4 Gerdas Farm

Texas Co. Company

Contractor

Bedford


330 Ft. from N. Line

_____ Ft. from S. Line

_____ Ft. from E. Line

330 Ft. from W. Line

NW NW SW

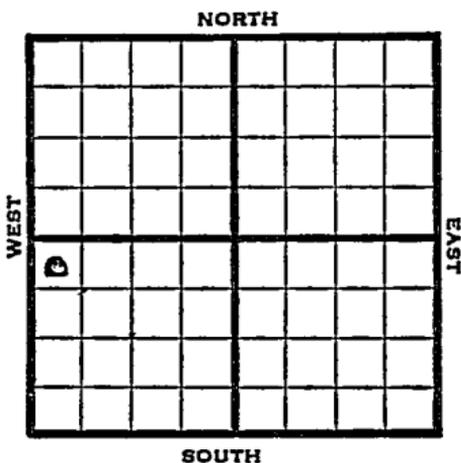

1950

Elev 1865

REPORT

5/10

Location

6/14

10" @ 691
 Br. Lime 3384
 Lans. 3412
 Arb. 2855-59
 5" @ 2856
 S/ 36 bo 32 bw 14 hr
 300 acid
 S/125 bo 82 bw 5 hr
 Comp 84 bo 215 bwpd
 Completed

COMPLETED

Map No. _____ Sec. 28 Twp. 23 R. 12 W

Well No. 4 Gerdes

Texas Co. _____ Company

Contractor _____

NW NW SW


SECTION PLAT

330 Ft. from N. Line

_____ Ft. from S. Line

_____ Ft. from E. Line

330 Ft. from W. Line

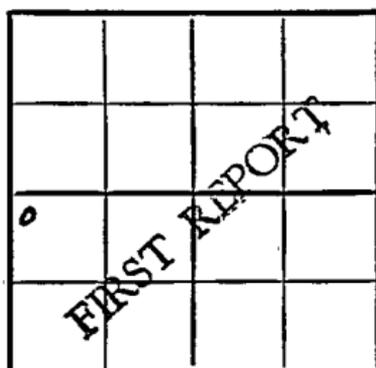

Bedford

Location _____ X

Rig up _____

Drilling and Remarks:

RECORD

Cased _____ in., _____ ft.

Sand _____

Gas _____

Oil _____

Total Depth _____

PRODUCTION

1st 24 hrs. Nat. _____

1st 24 hrs. after shot _____

Gas _____ Cu. Ft.

Dry Hole _____

Abandoned _____

Date

MAY 20 1959 19

J. E. TYRA Scout

Kansas

Map No. _____ Sec. 28 Twp. 23 R. 12W

Well No. 4 Gerdes

_____ Texas _____ Company

_____ Contractor

NW Nth SW

El. 1865


SECTION PLAT

330 Ft. from N. Line

_____ Ft. from S. Line

_____ Ft. from E. Line

330 Ft. from W. Line

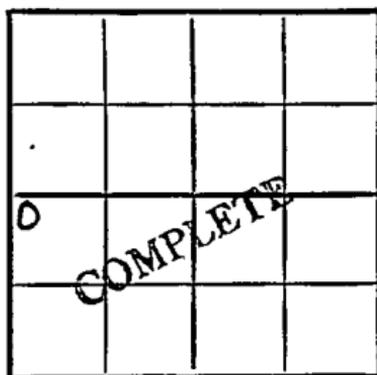

Stafford County

Location _____

Rig up _____

Drilling and Remarks:

10" @ 691
 Br. lime 3384
 Lans. 3412
 Arb. 3855-59
 7" C 3856

RECORD

Cased _____ in., _____ ft.
 Sand _____
 Gas _____
 Oil _____
 Total Depth _____

PRODUCTION

1st 24 hrs. Nat. _____
 1st 24 hrs. after shot _____
 Gas _____ Cu. Ft.
 Dry Hole _____
 Abandoned _____

Date

JUN 14 1950 19

J. E. TYRA Scout

S/ 36 bo 32² bw

300 acid

S/ 125 bo 82 bw

Comp 84 bo 215

4 hr.
Misc.
Pierce Map
France Map
5 hr.
Tracings
Land Wall Map
Land Small Map
Scout Cards

JUN 19 1950

RECORDED

INDEXED

FILED










