

Sec. 28 Twp. 23 R. 12-W

Well No. #1 Heyen Farm

Cities-Service Oil Company

(Stafford)


330 Ft. from N. Line

_____ Ft. from S. Line

990 Ft. from E. Line

_____ Ft. from W. Line

Elev. 1858

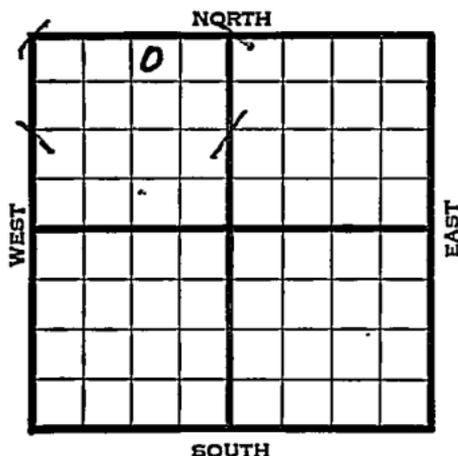

1940	REPORT
10/9	Drlg. 200'
10/17	8" - 285' Drlg. 3105'
10/24	Anhy 680' Topeka 2950'
	Lans. 3385' Viola 3703'
	Arb. 3824-26 ³⁸⁴¹ T.D. 5" - 3825'
	RUST.
10/31	Arb. 3841' (Corrected)
	8" - 3841' T.D. 3847'
	Pump 120 bbls. 11 hours.
11/7	500 acid. Pump 165 oil 6 hours.
11/13	Arb. 3841'
	8" - 3841'
	T.D. 3847'
	500 acid.
	Depthograph potential 8087 bbls.
	Maximum 3000 bbls.
	COMPLETED

Map No. 47 Sec. 28 Twp. 23 R. 12W

Well No. 1 Heyen

Cities Service Oil Company

Contractor

FIRST REPORT

NW NE NW

330 Ft. from N. Line


_____ Ft. from S. Line

990 Ft. from E. Line

_____ Ft. from W. Line

STAFFORD POOL

SECTION PLAT

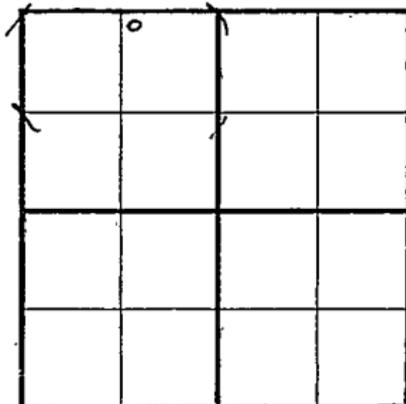

Location _____

Rig up _____

Drilling and Remarks:

Drlg 200

RECORD

Cased _____ in., _____ ft.

Sand _____

Gas _____

Oil _____

Total Depth _____

PRODUCTION

1st 24 hrs. Nat. _____

1st 24 hrs. after shot _____

Gas _____ Cu. Ft.

Dry Hole _____

Abandoned _____

Date

OCT 9 1940 19

S. I. LEWIS Scout

Map No. 47 Sec. 28 Twp. 23 R. 12W

Well No. 1 Heyen

Cities Service Oil Company

Contractor

COMPLETED

SECTION PLAT

NW NE NW

330 Ft. from N. Line

_____ Ft. from S. Line

990 Ft. from E. Line

_____ Ft. from W. Line

	o		

STAFFORD POOL

Location _____

Rig up _____

Drilling and Remarks:

cut 3841
81103841
500 acid
Depth 8057

Mag 3000

RECORD

Cased _____ in., _____ ft.

Sand _____

Gas _____

Oil _____

Total Depth 3847

PRODUCTION

1st 24 hrs. Nat. _____

1st 24 hrs. after shot _____

Gas _____ Cu. Ft.

Dry Hole _____

Abandoned _____

Date

NOV 13 1940 19 _____

S. J. LEWIS Scout