

KANSAS

Form 51-5M-7-40-Palace

Stafford

Section 28 Township 23- Range 12-W

Well No. #2 Heyen

Company Cities Service Oil

Stafford Pool

NORTH

			0				

WEST

EAST

SOUTH

3

Sec. 28 Twp. 23 R. 12-W

Well No. #2 Heyen Farm _____

Sities Service Oil Company

(Stafford)


990 Ft. from N. Line

_____ Ft. from S. Line

330 Ft. from E. Line

_____ Ft. from W. Line

Elev. 1863

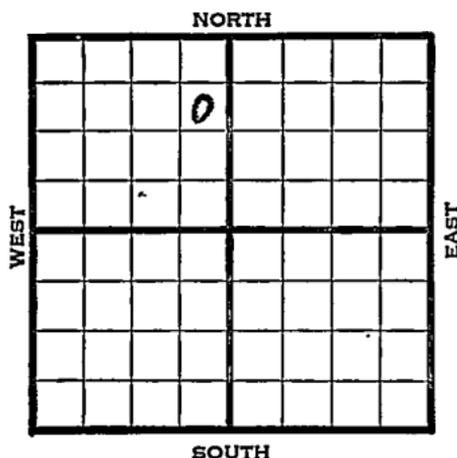

1940	REPORT
11/13	Location
11/21	8" - 285' Drlg. 1120'
11/27	Drlg. 3415'
12/5	Arb. 3843-44' T.D. 5" - 3843' RUST.
12/12	T.D. 3851' Depthograph potential 2209 bbls.
12/18	Viola 3722' 5" - 3843' Simp. 3800' T.D. 3851' 500 acid. 2000 acid. Echometer potential 8014 bbls. Maximum 3000 bbls. 46.2 Gravity
	COMPLETED

Map No. 47 Sec. 28 Twp. 23 R. 12WWell No. 2 HeyenCities Service Oil Company

Contractor

FIRST REPORT

SE NE NW

990 Ft. from N. Line Ft. from S. Line330 Ft. from E. Line Ft. from W. Line

STAFFORD POOL

SECTION PLAT

		o	

Location XRig up

Drilling and Remarks:

RECORDCased in., ft.Sand Gas Oil Total Depth **PRODUCTION**1st 24 hrs. Nat. 1st 24 hrs. after shot Gas Cu. Ft.Dry Hole Abandoned

Date

NOV 13 1940 19S. J. LEWIS

Scout

Map No. 47 Sec. 28 Twp. 23 R. 12W

Well No. 2 Heyen

Cities Service Oil Company

Contractor

COMPLETED

SE NE NW

990 Ft. from N. Line

_____ Ft. from S. Line

330 Ft. from E. Line

_____ Ft. from W. Line

STAFFORD POOL

SECTION PLAT

	o		

Location _____

Rig up _____

Drilling and Remarks:

Vidla 3722

5" C 3848

Strip 3500

500 acid

2000 acid

Ech no P 8 8014

Max 3000

46² SR

Date

RECORD

Cased _____ in., _____ ft.

Sand _____

Gas _____

Oil _____

Total Depth 3851

PRODUCTION

1st 24 hrs. Nat. _____

1st 24 hrs. after shot _____

Gas _____ Cu. Ft.

Dry Hole _____

Abandoned _____

DEC 18 1940 19

S. J. LEWIS Scout