

KARLAS

FORM 51 5M 4-41 PETROL


Stafford

Section 28 Township 23 Range 12-W

Well No. 1 Heyen "B"

Company Shell

NORTH Bedford Pool

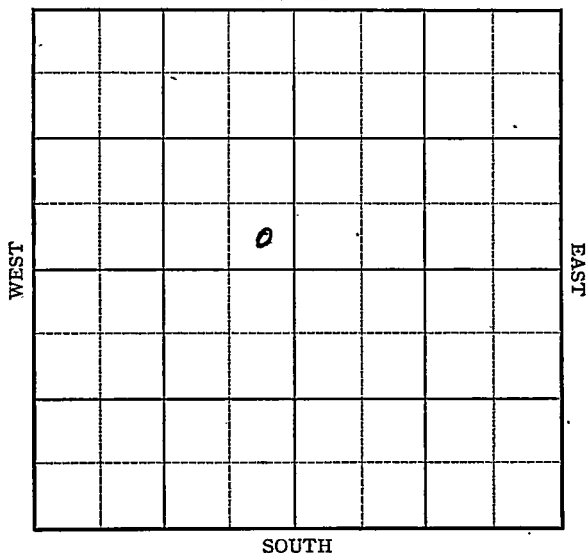


6

Sec. 28 Twp. 23 R. 12-WWell No. #1 Hey en "B" FarmShell Company

(Bedford)

 Ft. from N. Line330 Ft. from S. Line330 Ft. from E. Line Ft. from W. Line

Elev. 1862

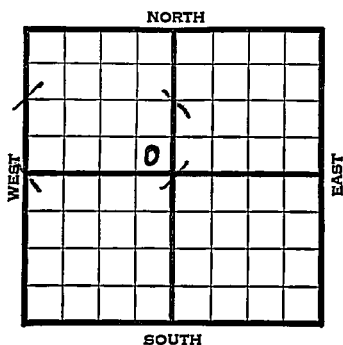

1941	REPORT
5/7	Location
5/15	8" - 312' Drlg. 1735'
5/22	Fsg. 3522'
5/28	Viola 3719' Arb. 3844-46' T.D.
	4" - 3845' RUST.
6/5	T.D. 3847' 500 acid.
	Swab 283 oil in 5 hours.
6/12	" " " "
6/18	Arb. 3844'
	4" - 3845'
	T.D. 3847'
	500 acid.
	Depthograph potential 8237 bbls.
	Maximum 3000 bbls.
	34. Gravity
	COMPLETED

Map No. 47 Sec. 28 Twp. 23 R. 12WWell No. 1 Heyen "B"Shell

Company

FIRST REPORT


Contractor

SECTION PLAT

SE NW

 Ft. from N. Line330 Ft. from S. Line330 Ft. from E. Line Ft. from W. Line

BEDFORD POOL

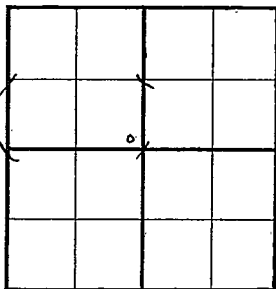Location XRig up

Drilling and Remarks:

RECORD

Cased in., ft.Sand Gas Oil Total Depth

PRODUCTION

1st 24 hrs. Nat. 1st 24 hrs. after shot Gas Cu. Ft.Dry Hole Abandoned

Date

MAY 7 1944 19

S. J. LEWIS

Scout

Map No. 47 Sec. 28 Twp. 23 R. 12WWell No. 1 Heyen "B"Shell

Company

Contractor

COMPLETED


SE NW

Ft. from N. Line

330 Ft. from S. Line330 Ft. from E. Line

Ft. from W. Line

SECTION PLAT

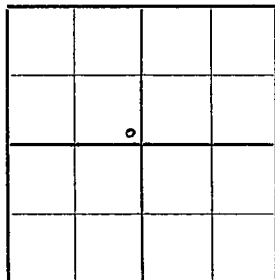

BEDFORD POOD

Location

Rig up

Drilling and Remarks:

Cr Y 3844
4" @ 3845
500 acid
Dep H₂O 88237
Max 3000
342 gr

RECORD

Cased _____ in., _____ ft.

Sand _____

Gas _____

Oil _____

Total Depth 3847

PRODUCTION

1st 24 hrs. Nat. _____

1st 24 hrs. after shot _____

Gas _____ Cu. Ft.

Dry Hole _____

Abandoned _____

Date

JUN 18 1941 19

S. J. LEWIS Scout