


DX 78-1 Stafford

**KANSAS**

Section 28 Township 23S Range 12W

Well No. #1 Knocke (Knoche)

Company B & R Drlg Co.

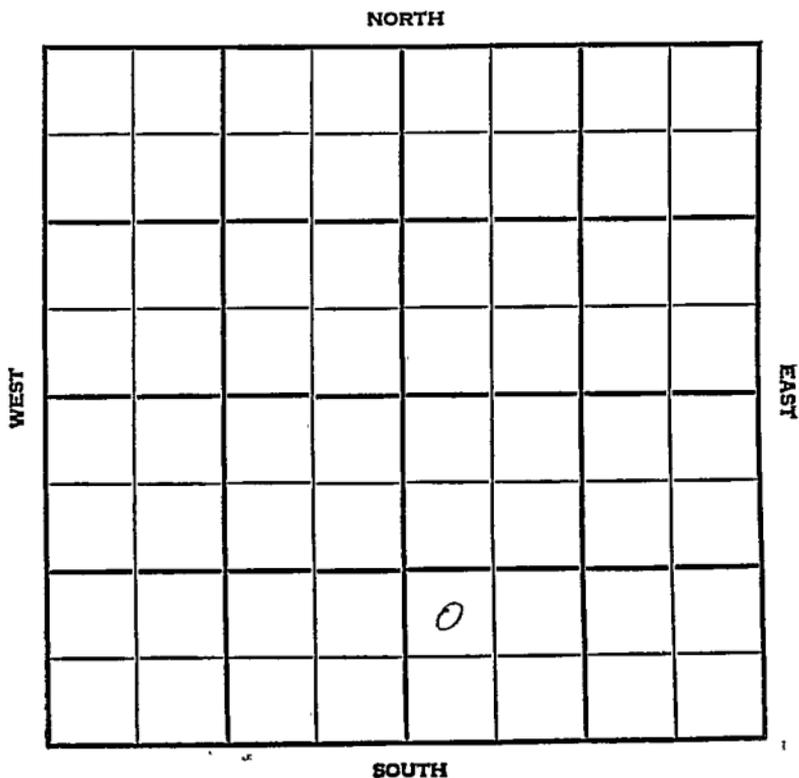



County Stafford Elev. \_\_\_\_\_  
 Sec. 28 Twp. 23S Rge. 12W  
 Company B & R Drlg Co.  
 Farm Name Knoeke No. 1

TOPS	DEPTH	LOG	DATUM
Anh.			
TP.			
H.			
Tr.			
Dg.			
Bl.			
L.			
K.C.			
B.K.C.			
Ce.			
C.			
M.			
M.			
K.			
Mz.			
Me.			
V.			
S.			
S.			
A.			
R.			
PE.			
G.			
T.D.			

Loc. in Sec. NWSW SE

Geol. \_\_\_\_\_

Contr. CO.

Pool Bedford

FIRST REPORT		
AUG 22 '56		
0		

Date Comm. 8-11-56  
8" 235; D. 3200

D.N.

Co.

Lse.

No.

Sec.

T.

R.

County Stafford Elev. 1860  
 Sec. 28 Twp. 23S Rgn. 12W  
 Company B & R Drlg Co.  
 Farm Name Knocke No. 1

TOPS	DEPTH	LOG	DATUM
Anh.			
Tp.			
H.	<u>3244</u>		
Tr.	<u>3261</u>		
Dg.	<u>3282</u>		
Bl.	<u>3384</u>		
L.	<u>3417</u>		
K.C.			
B.K.C.			
Ce.			
C.			
M.			
M.			
K.			
Mz.			
Mo.			
V.			
S.	<u>Dold 3818</u>		
S.			
A.	<u>3859</u>		
R.			
Pe.			
G.			
TD.	<u>3862</u>		

Loc. in Sec. NWSW SE

Geol. \_\_\_\_\_

Contr. \_\_\_\_\_

CO.

Pool \_\_\_\_\_

Bedford

ABANDONED

SEP 5 '56

0

Date Comm. 8-14-56

8" 235; D 3200 AUG 29 '55 DST 3818-40

1 hr, 20' Md BHP 0/20"

no Log 5 1/2 @ 3859/110 SEP 5 '56

co 3862 Hole Full w/

D&A

Co.

Loc.

No.

Sec.

T.

R.