


Section 28 Township 23 Range 12W

Well No. #1 Kanoche (Knoche)

Company Cities Service Oil.

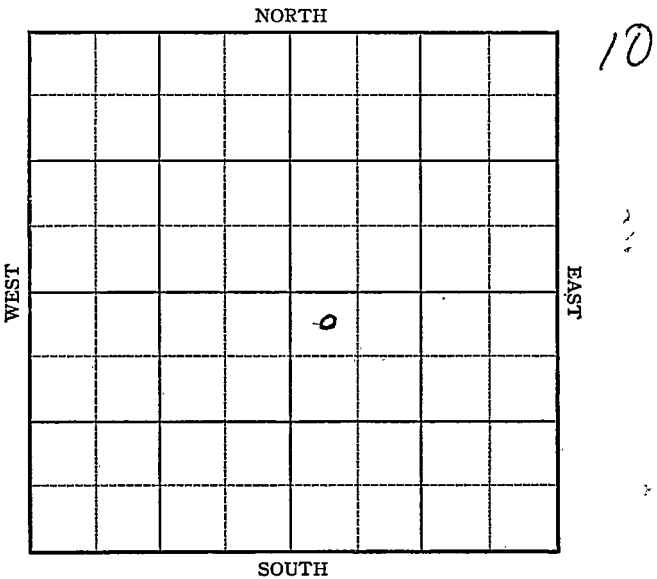

Sec. 28 Twp. 23 R. 12-W

Well No. #1 Kan oche Farm

Cities Service Oil Company

(Bedford)


330 Ft. from N. Line

\_\_\_\_\_ Ft. from S. Line

\_\_\_\_\_ Ft. from E. Line

330 Ft. from W. Line

Elev. 1859

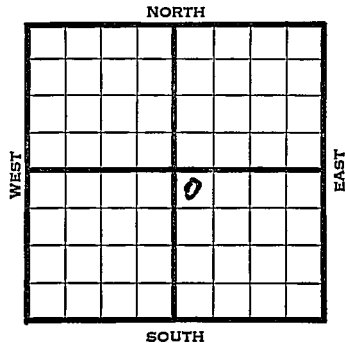

1941	REPORT
6/25	Location
7/3	8" - 305' WOC.
7/10	Drlg. 3645'
7/17	Lans. 3403' B.K.C. 3647'
	Viola 3725' Simp. 3775'
	Arb. 3840-42' T.D. 5" - 3842'
	RUST.
7/24	" " " " "
8/30	Arb 3840'
	MD 3847'
	5" @ 3842'
	Echo Potential 2235'
	40. Gravity.
	<b>COMPLETED</b>

Map No. 47 Sec. 28 Twp. 23 R. 12WWell No. 1 KanocheCities Service Oil Company

Contractor

## FIRST REPORT

NW SE

330 Ft. from N. Line

Ft. from S. Line

Ft. from E. Line

330 Ft. from W. Line

BEDFORD POOL

## SECTION PLAT

		o	

Location X

Rig up \_\_\_\_\_

Drilling and Remarks:

## RECORD

Cased \_\_\_\_\_ in., \_\_\_\_\_ ft.

Sand \_\_\_\_\_

Gas \_\_\_\_\_

Oil \_\_\_\_\_

Total Depth \_\_\_\_\_

## PRODUCTION

1st 24 hrs. Nat. \_\_\_\_\_

1st 24 hrs. after shot \_\_\_\_\_

Gas \_\_\_\_\_ Cu. Ft.

Dry Hole \_\_\_\_\_

Abandoned \_\_\_\_\_

Date

JUN 25 1941

19

S. J. LEWIS

Scout

**KANSAS**

Map No. 47 Sec. 28 Twp. 23 R. 12W

Well No. 1 Kanoche

Cities Service Oil Company

COMPLETED Contractor

**SECTION FLAT**

		•	

NW SE  
330 Ft. from N. Line

\_\_\_\_\_ Ft. from S. Line

\_\_\_\_\_ Ft. from E. Line

330 Ft. from W. Line

**BEDFORD POOL**

**RECORD**

Location \_\_\_\_\_

Cased \_\_\_\_\_ in., \_\_\_\_\_ ft.

Rig up \_\_\_\_\_

Sand \_\_\_\_\_

Drilling and Remarks:

Gas \_\_\_\_\_

Oil \_\_\_\_\_

Total Depth 3847

*Cor 8840*

*5" @ 3842*

*Echd P 2235*

**PRODUCTION**

1st 24 hrs. Nat. \_\_\_\_\_

1st 24 hrs. after shot \_\_\_\_\_

Gas \_\_\_\_\_ Cu. Ft.

Dry Hole \_\_\_\_\_

Abandoned \_\_\_\_\_

*40 @ 42*

Date

JUL 30 1941

S. I. LEWIS Scout