

KANSAS


Stafford

FORM 51 5M 4-41 PETROL

Section 28 Township 23 Range 12-W

Well No. #2 Knoche

Company Cities Service Oil

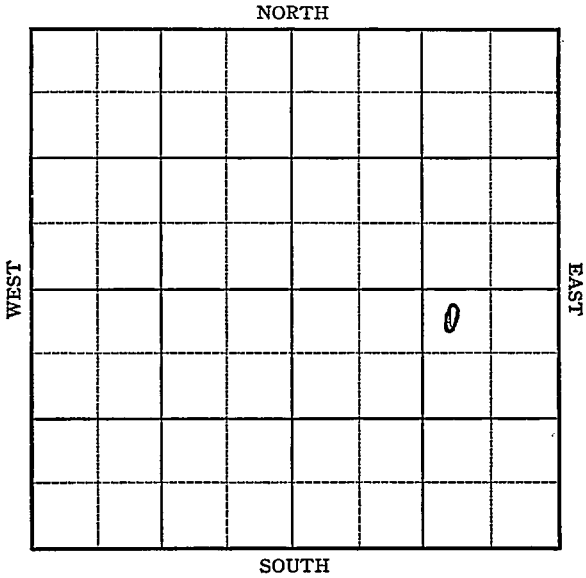

Sec. 28 Twp. 23 R. 12-W

Well No. #2 Knoche Farm

Cities Service Oil Company

(Bedford)


330 Ft. from N. Line

_____ Ft. from S. Line

990 Ft. from E. Line

_____ Ft. from W. Line

Elev. 1863

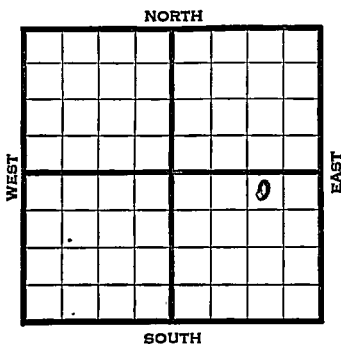

1941	REPORT
10/22	8" - 310' WOC.
10/30	Drlg. 3525'
11/6	Arb. 3829 ³⁸²⁹ - 3835 ³⁸³⁵ T.D. 5" - 3834 ³⁸³⁰
	RUST.
11/13	Arb. 3829' (Corrected)
	5" - 3830' T.D. 3840' H.F.O.
11/19	Arb. 3829'
	5" - 3830'
	T.D. 3840'
	Depthograph potential 3564 bbls.
	Maximum 3000 bbls.
	41.6 Gravity
	COMPLETED

Stafford

KANSAS

Map No. K-47 Sec. 28 Twp. 23 R. 12W

Well No. 2 Knoche

Cities Service Oil Company

FIRST REPORT

Contractor

NW NE SE

SECTION PLAT

330 Ft. from N. Line

_____ Ft. from S. Line

990 Ft. from E. Line

_____ Ft. from W. Line

			6

BEDFORD POOL

Location _____

Rig up _____

Drilling and Remarks:

8" - 310'

Waiting on
Cement to set

RECORD

Cased _____ in., _____ ft.

Sand _____

Gas _____

Oil _____

Total Depth _____

PRODUCTION

1st 24 hrs. Nat. _____

1st 24 hrs: after shot _____

Gas _____ Cu. Ft.

Dry Hole _____

Abandoned _____

Date

OCT 22 1941 19

S. J. LEWIS

Scout

Stafford

KANSAS

Map No. π-47 Sec. 28 Twp. 23 R. 12W

Well No. 2 Knoche

Cities Service Oil Company

COMPLETED Contractor

NW NE SE

330 Ft. from N. Line

_____ Ft. from S. Line

990 Ft. from E. Line

_____ Ft. from W. Line

SECTION PLAT

			NO

BEDFORD POOL

RECORD

Location _____

Cased _____ in., _____ ft.

Rig up _____

Sand _____

Drilling and Remarks:

Gas _____

Cor 83529

Oil _____

5" @ 3830

Total Depth 3840

Sept 28 83564

110 x 3000

PRODUCTION

1st 24 hrs. Nat. _____

1st 24 hrs. after shot _____

Gas _____ Cu. Ft.

Dry Hole _____

Abandoned _____

416 gr

Date

NOV 19 1941

19

S. J. LEWIS

Scout