

KANSAS

FORM 51 5M 4-41 PETROL


Stafford

Section 28 Township 23 Range 12-W

Well No. 5 Meyer

Company British American

NORTH Bedford pool

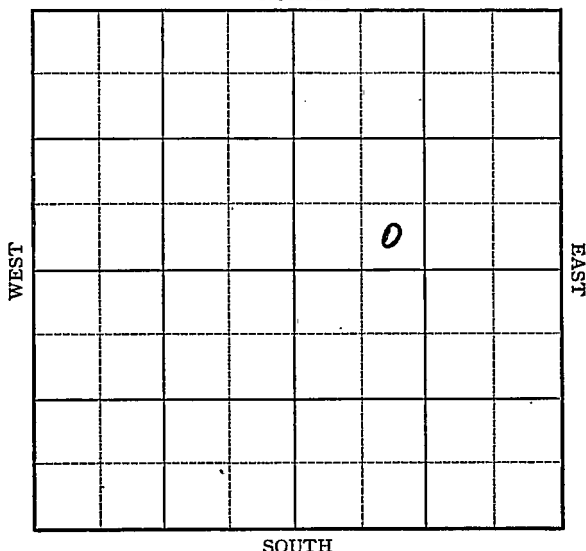

Map No. 47 Sec. 28 Twp. 23 R. 12WWell No. 5 MeyerBritish American Company**FIRST REPORT** Contractor

SE SW NE

SECTION PLAT

 Ft. from N. Line330 Ft. from S. Line Ft. from E. Line990 Ft. from W. Line

BEDFORD POOL

Location Rig up

Drilling and Remarks:

9" - 351

Dr1g. 2035

RECORDCased in., ft.Sand Gas Oil Total Depth **PRODUCTION**1st 24 hrs. Nat. 1st 24 hrs. after shot Gas Cu. Ft.Dry Hole Abandoned

Date

AUG 20 1941 19S. J. LEWIS Scout

Stafford **KANSAS**Map No. 47 Sec. 28 Twp. 23 R. 12WWell No. 5 MeyerBritish American

Company

~~COMPLETED~~

Contractor

SE SW NE

SECTION PLAT

		o	

Ft. from N. Line

330 Ft. from S. Line

Ft. from E. Line

990 Ft. from W. Line

BEDFORD POOL

Location

Rig up

Drilling and Remarks:

*Cr & 3830.**5" @ 3826**500 aciol**Sept 18 P & 3000**45-2-6*

RECORD

Cased _____ in., _____ ft.

Sand _____

Gas _____

Oil _____

Total Depth 3849

PRODUCTION

1st 24 hrs. Nat. _____

1st 24 hrs. after shot _____

Gas _____ Cu. Ft.

Dry Hole _____

Abandoned _____

Date

SEP 17 1941 19

S. J. LEWIS

Scout