

Sec. 28 Twp. 23 R. 12-W

Well No. #6 Meyer Farm

British American Company


(Bedford)

 Ft. from N. Line

330 . Ft. from S. Line

330 Ft. from E. Line

 Ft. from W. Line

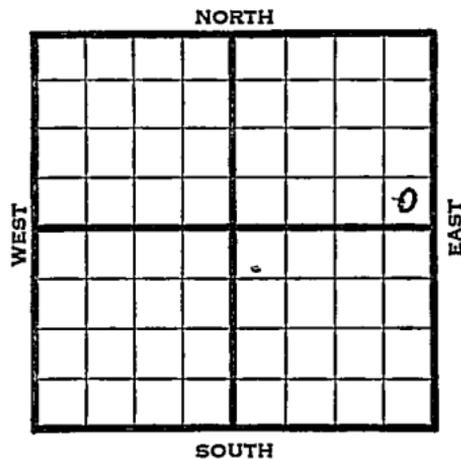

Elv. 186'

1941

REPORT

12/30

9" - 347'

Drlg. 2220'

1942

1/8

Lans. ~~3400'~~ 3392'

Drlg. 3494'

1/15

Lans. 3392' (Corrected)

Cong. 3696' Viola ~~3706'~~ 3701'

Drlg. 3837'

1/22

Viola 3701' (Corrected)

Arb. 3820' 5" - 3820'

T.D. 3838' 3470' oil.

1/29

Simpson 3760'

T.D. 3843' SD.

OVER

1942

2/4

Arb. 3820'

5" - 3820'

T.D. 3843'

Depthograph potential 4038 bbls.

Maximum 3000 bbls.

36. Gravity

COMPLETED

Map No. 47 Sec. 28 Twp. 23 R. 12W

Well No. 6 Meyer

British American Company

FIRST REPORT Contractor

SE NE

_____ Ft. from N. Line

330 Ft. from S. Line

330 Ft. from E. Line

_____ Ft. from W. Line

SECTION PLAT

			o

BEDFORD POOL

Location _____

Rig up _____

Drilling and Remarks:

9" - 347'

Drlg. 2220'

RECORD

Cased _____ in., _____ ft.

Sand _____

Gas _____

Oil _____

Total Depth _____

PRODUCTION

1st 24 hrs. Nat. _____

1st 24 hrs. after shot _____

Gas _____ Cu. Ft.

Dry Hole _____

Abandoned _____

Date

DEC 3 0 1941 19

S. J. LEWIS Scout

