

Section 28 Township 23 Range 12-W

Well No. #1 Heyen

Company Brunson Drlg.

NORTH

0							

5

WEST

EAST

SOUTH

Sec. 28 Twp. 23 R. 12W

Well No. #1 Heyen Farm

Brunson Drlg. Company

Brunson Drlg. - Contr. Contractor

Heyen Pool


           Ft. from N. Line

990' Ft. from S. Line

           Ft. from E. Line

330' Ft. from W. Line

NW SW NW

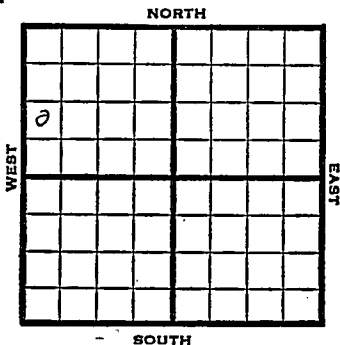

1950

Elev 1863' REPORT

11/15

Spud 11-14-50

12/6

8" @ 158

Anhy 670

Arb 3844

TD 3847

5" @ 3847

TD 3856

HFW

TD 3856

D&A

**ABANDONED**

County Stafford State Kansas

Sec. 28 (<sup>Blk.</sup><sub>Twp.</sub>) 23 (<sup>Sur.</sup><sub>Rge.</sub>) 12W Map No.

Operator Brunson Drlg.

Well No. 1 Farm Heyen

Elev. \_\_\_\_\_ Location NW SW NW

0					
<b>FIRST REPORT</b>					

990 Ft. From S Line NW

330 Ft. From W Line Quarter

Ist. Report NOV 15 1950

Completion \_\_\_\_\_

Remarks \_\_\_\_\_

Brunson Drlg. - Contr.

Spudding Date 11-14-50

Drlg. Data Heyen Pool

County Stafford State Kansas

Sec. 28 (Blk. 23 (Sur. 12W Map No. (Twp.) (Rge.))

Operator Brunson Drlg.

Well No. 1 Farm Heven

Elev. 1863 Location NW SW NW


990 Ft. From S Line NW

330 Ft. From W Line Quarter

1st. Report

Completion DEC 6 1950

Remarks Heven Pool

Brunson Drlg. - Contr.

Spudding Date 11-14-50

Drlg. Data D & A TD 3856

8" @ 158 Anhy 670 Arb. 3844

TD 3847 5" C 3847 TD 3856 HFW

D & A