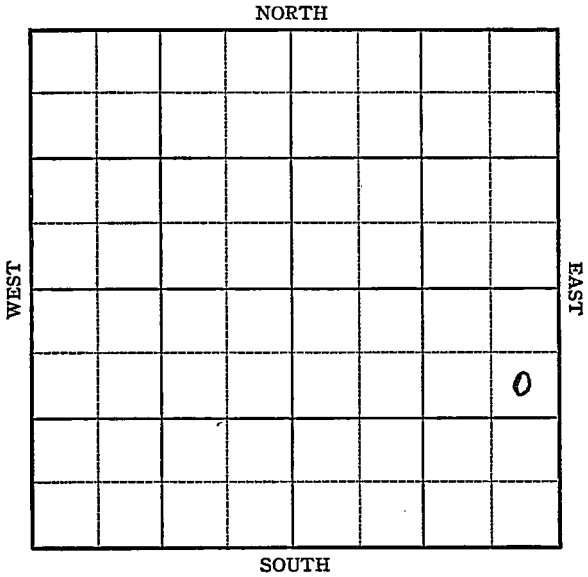


Section 28 Township 23 Range 12-W

Well No. #3 Knoche

Company Cities Service Oil



9

Stafford

Sec. 28 Twp. 23 R. 12-W

Well No. #3 Knoche Farm

Cities Service Oil _____ Company

(Bedford)

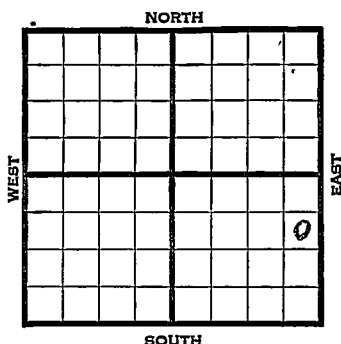
990 Ft. from N. Line

Ft. from S. Line

330 Ft. from E. Line

Ft. from W. Line

Elev. 1864

[illegible]

Map No. 1147 Sec. 28 Twp. 23 R. 12WWell No. 3 KnochCities Service Oil CompanyFIRST REPORT Contractor

SE NE SE

SECTION PLAT

			o

990 Ft. from N. Line Ft. from S. Line330 Ft. from E. Line Ft. from W. Line

BEDFORD POOL

Location Rig up

Drilling and Remarks:

8" - 225'

Drlg. 1640'

RECORD

Cased in., ft.Sand Gas Oil Total Depth

PRODUCTION

1st 24 hrs. Nat. 1st 24 hrs. after shot Gas Cu. Ft.Dry Hole Abandoned

Date

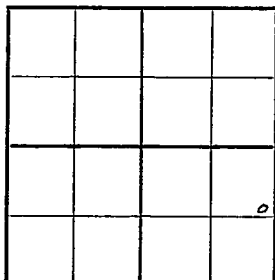
NOV 25 1941 19

S. J. LEWIS Scout

Map No. 47 Sec. 28 Twp. 23 R. 12WWell No. 3 KnocheCities Service Oil CompanyCOMPLETED Contractor

SE NE SE

SECTION PLAT

990 Ft. from N. Line Ft. from S. Line330 Ft. from E. Line Ft. from W. Line

BEDFORD POOL

Location Rig up

Drilling and Remarks:


RECORD

Cased in., ft.Sand Gas Oil Total Depth 3846

PRODUCTION

1st 24 hrs. Nat. 1st 24 hrs. after shot Gas Cu. Ft.Dry Hole Abandoned

Date

DEC 23 1941

19

S. J. LEWIS Scout