

KANSAS


Stafford

Form 51-5M-7-40-Palace

Section 28 Township 23 Range 12-W

Well No. #2 Meyer

Company British American

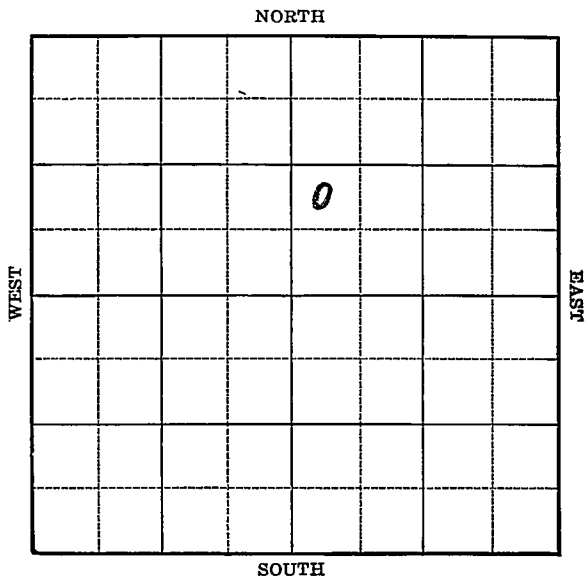


Sec. 28 Twp. 23 R. 12-WWell No. #2 Meyer FarmBritish American Company

(Bedford)

 Ft. from N. Line990 Ft. from S. Line Ft. from E. Line330 Ft. from W. Line

Elev. 1861

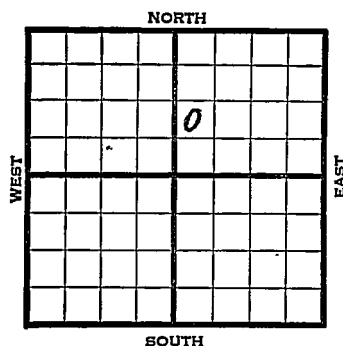

1940	REPORT
12/30	9" - 300' WOC.
1941	
1/9	Drlg. 2450'
1/16	Drlg. 3020'
1/23	Lans. 3392' Viola 3706'
	Simp. 3767' Coring 3823'
1/30	Arb. 3828' 5" - 3828'
	T.D. 3841' 200' oil.
2/5	Arb. 3828'
	5" - 3828'
	T.D. 3841'
	2000 acid.
	Echometer potential 3235 bbls.
	Maximum 3000 bbls.
	42.6 Gravity
	COMPLETED

Map No. 47 Sec. 28 Twp. 23 R. 12WWell No. 2 MeyerBritish American CompanyFIRST REPORT Contractor

NW SW NE

SECTION PLAT

		o	

 Ft. from N. Line990 Ft. from S. Line Ft. from E. Line330 Ft. from W. Line

BEDFORDPOOL

Location Rig up

Drilling and Remarks:

9" - 300

WOC

RECORDCased in., ft.Sand Gas Oil Total Depth **PRODUCTION**1st 24 hrs. Nat. 1st 24 hrs. after shot Gas Cu. Ft.Dry Hole Abandoned

Date

DEC 30 1940 19S. J. LEWIS Scout

Map No. 47 Sec. 28 Twp. 23 R. 12WWell No. 2 MeyerBritish American CompanyCOMPLETED Contractor

SECTION PLAT

NW SW NE

 Ft. from N. Line990 Ft. from S. Line Ft. from E. Line330 Ft. from W. Line

BEDFORD POOL

		o	

Location Rig up

Drilling and Remarks:

*Cr 3828**5" @ 3828**2000 acust**Echo Pad 3235**May 3000**42.6 Gr*

RECORD

Cased in., ft.Sand Gas Oil Total Depth 3841

PRODUCTION

1st 24 hrs. Nat. 1st 24 hrs. after shot Gas Cu. Ft.Dry Hole Abandoned

Date

FEB 5 1941 19 S. J. LEWIS Scout