


# KANSAS Stafford

Form 51-5M-7-40-Palace

Section 28 Township 23 Range 12 -W

Well No. #3 Meyer

Company British American

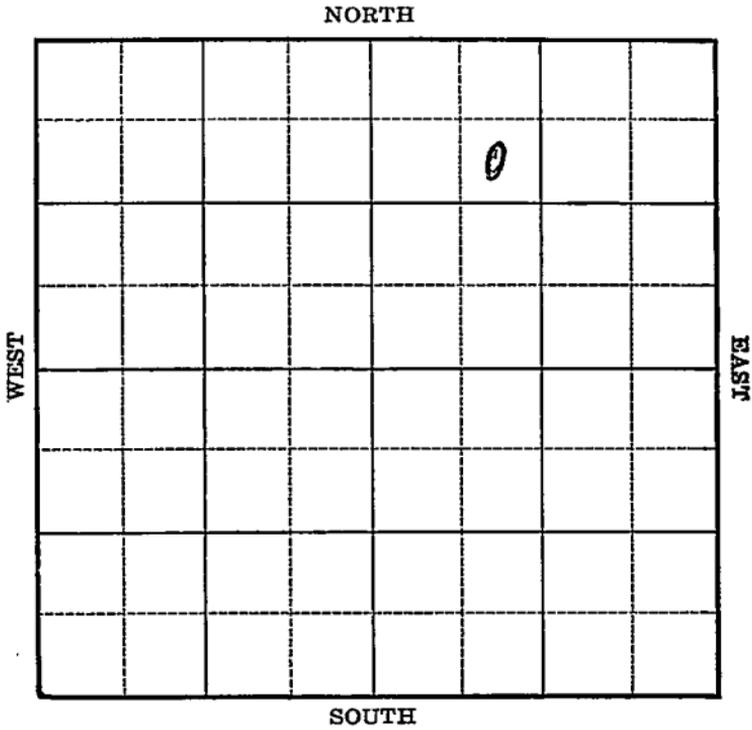



Map No. 47 Sec. 28 Twp. 23 R. 12WWell No. 3 MeyerBritish American CompanyFIRST REPORT Contractor**SECTION PLAT**990 SE NW NE  
Ft. from N. Line

\_\_\_\_ Ft. from S. Line

\_\_\_\_ Ft. from E. Line

990 Ft. from W. Line

BEDFORD POOL

		o	

Location \_\_\_\_\_

Rig up \_\_\_\_\_

Drilling and Remarks:

ROG

**RECORD**

Cased \_\_\_\_\_ in., \_\_\_\_\_ ft.

Sand \_\_\_\_\_

Gas \_\_\_\_\_

Oil \_\_\_\_\_

Total Depth \_\_\_\_\_

**PRODUCTION**

1st 24 hrs. Nat. \_\_\_\_\_

1st 24 hrs. after shot \_\_\_\_\_

Gas \_\_\_\_\_ Cu. Ft.

Dry Hole \_\_\_\_\_

Abandoned \_\_\_\_\_

Date

FEB 5 1941 19S. I. LEWIS Scout

Map No. 47 Sec. 28 Twp. 23 R. 12WWell No. 3 MeyerBritish American Company~~CONTRACTOR~~ Contractor

SE NW NE

990 Ft. from N. Line

\_\_\_\_\_ Ft. from S. Line

\_\_\_\_\_ Ft. from E. Line

990 Ft. from W. Line

BEDFORD POOL

## SECTION PLAT

		6	

Location \_\_\_\_\_

Rig up \_\_\_\_\_

Drilling and Remarks:

*Cr 83817 1/2**5" @ 3878**5000 acid**Echo P 83000**42 @ 3878*

## RECORD

Cased \_\_\_\_\_ in., \_\_\_\_\_ ft.

Sand \_\_\_\_\_

Gas \_\_\_\_\_

Oil \_\_\_\_\_

Total Depth 3842

## PRODUCTION

1st 24 hrs. Nat. \_\_\_\_\_

1st 24 hrs. after shot \_\_\_\_\_

Gas \_\_\_\_\_ Cu. Ft.

Dry Hole \_\_\_\_\_

Abandoned \_\_\_\_\_

Date

APR 2 1941 19

S. J. LEWIS Scout