

KANSAS


Form 51-5M-7-40-Palace

Stafford

Section 28 Township 23 Range 12-W

Well No. #4 Meyers

Company British American Bedford Pool

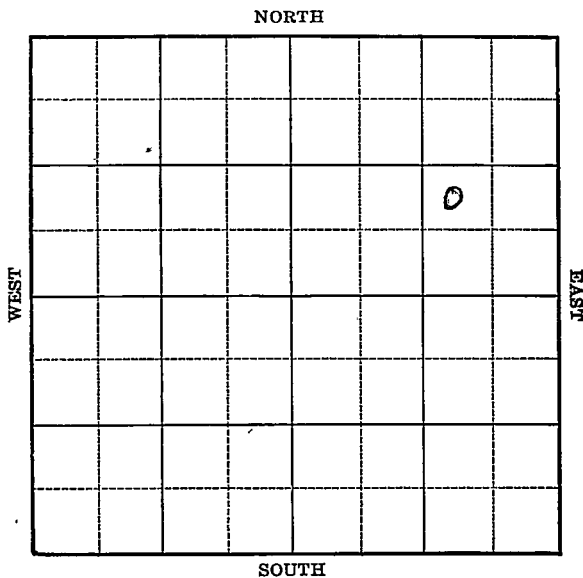


KANSAS

Stafford

FORM 252-A 5M 1-41 PETROL

Sec. 28 Twp. 23 R. 12-WWell No. #4 Meyers FarmBritish American Company
(Bedford) Ft. from N. Line990 Ft. from S. Line990 Ft. from E. Line Ft. from W. Line

Elev. 1861

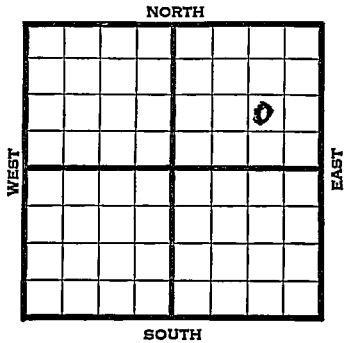

1941

REPORT

4/2

Location

4/10

"

4/18

9-5/8" - 327'

4/24

Anhy 665' Drlg. 2441'

5/1

Drlg. 3670'

5/8

Lans. 3400' Viola 3696'

Arb. 3834' 5" - 3834'

T.D. 3838' 3400' oil 8 hours.

5/14

Arb. 3834'

5" - 3834'

T.D. 3838'

2500 acid.

Echometer potential 41,800 bbls.

Maximum 3000 bbls.

42. Gravity

COMPLETED

Map No. 47 Sec. 28 Twp. 23 R. 12WWell No. 4 Meyers

British American

Company

FIRST REPORT

Contractor

NW SE NE

SECTION PLAT

			o

Ft. from N. Line

990 Ft. from S. Line

990 Ft. from E. Line

Ft. from W. Line

BEDFORD POOL

Location X

Rig up

Drilling and Remarks:

RECORD

Cased _____ in., _____ ft.

Sand _____

Gas _____

Oil _____

Total Depth _____

PRODUCTION

1st 24 hrs. Nat. _____

1st 24 hrs. after shot _____

Gas _____ Cu. Ft.

Dry Hole _____

Abandoned _____

Date

APR 2 1941
19

S. J. LEWIS Scout

Map No. 47 Sec. 28 Twp. 23 R. 12WWell No. 4 MeyersBritish American

Company

COMPLETED

Contractor

SECTION PLAT

NW SE NE

 Ft. from N. Line990 Ft. from S. Line990 Ft. from E. Line Ft. from W. Line**BEDFORD POOL**

			o

Location Rig up

Drilling and Remarks:

*Ar 3834**5" C 3834**2500 acid**Ech P 2 41500**M 3000**420 Ar.***RECORD**Cased in., ft.Sand Gas Oil Total Depth 3838**PRODUCTION**1st 24 hrs. Nat. 1st 24 hrs. after shot Gas Cu. Ft.Dry Hole Abandoned

Date

MAY 1 1941S. J. LEWIS Scout