

Section 28 Township 23 Range 13-WWell No. #1 O'ConnerCompany Plains Exploration

					0		

NORTH

WEST

EAST

SOUTH

Stafford

KANSAS

Sec. 28 Twp. 23 R. 13W

Well No. 1 0' Connor Farm

Plains Exploration Company

Carrie Drlg. Contractor

St. Johns Pool


 Ft. from N. Line

330' Ft. from S. Line

 Ft. from E. Line

990' Ft. from W. Line

SE SW SE

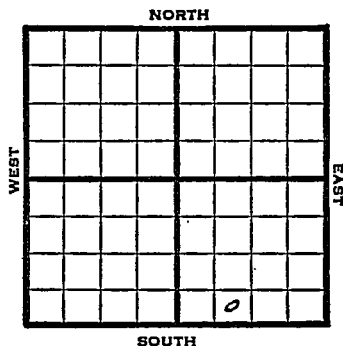

1950

Elev 1901' REPORT

4/5 8-5/8" @ 342'
Anhy 785-800'
Drlg. 2211'

4/19 TD 4020'
8 5/8" @ 342'
Anhy 785-800
KC 3528'
Heeb 3376'
Br Lime 3502'
Lans 3528'
Ch Cong 3884'
Simp 3958'
Arb. 4005-20
NS
D&A
Aband.

ABANDONED

Kansas

St. Johns Pool

Map No. _____ Sec. 28 Twp. 23 R. 13WWell No. 1 O'Conner

_____ Plains Exploration _____ Company

_____ Carrie Drlg. _____ Contractor


SE SW SE

SECTION PLAT

_____ Ft. from N. Line

330 Ft. from S. Line

_____ Ft. from E. Line

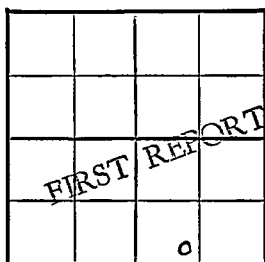990 Ft. from W. Line

Stafford County

Stanolind farmout

Location _____

Rig up _____

Drilling and Remarks:

8 5/8" @ 342

Anhy 785-800

drlg. 2211

RECORD

Cased _____ in., _____ ft.

Sand _____

Gas _____

Oil _____

Total Depth _____

PRODUCTION

1st 24 hrs. Nat. _____

1st 24 hrs. after shot _____

Gas _____ Cu. Ft.

Dry Hole _____

Abandoned _____

Date

APR 5 1950 19J. E. TYRA
Scout

Kansas

St. Johns Pool

Map No. _____ Sec. 28 Twp. 23 R. 13W

Well No. 10' Conner


Plains Exploration Company

Contractor

SE. SW SE

E 1.1901

SECTION PLAT

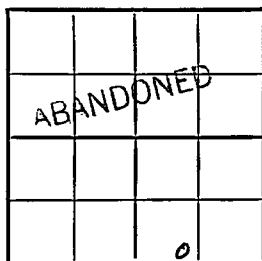

Ft. from N. Line

330 Ft. from S. Line

Ft. from E. Line

990 Ft. from W. Line

Stafford County

Location _____

Rig up _____

Drilling and Remarks:

8 5/8" C 342

any 785-800

K.C. 3528

Heel. 3376

Br. line 3502

Lans. 3528

Ch. Cns. 3884

RECORD

Cased _____ in., _____ ft.

Sand _____

Gas _____

Oil _____

Total Depth 4020

PRODUCTION

1st 24 hrs. Nat. _____

1st 24 hrs. after shot _____

Gas _____ Cu. Ft.

Dry Hole _____

Abandoned _____

Date

APR 19 1950 19

J. E. TYRA Scout

3958
4005-20

D & A

1
 2
APR

APR 28 1960

Scout Cards _____
Land Small Map _____
Land Wall Map _____
Tracings _____
France Map _____
Pierce Map _____
Misc. _____