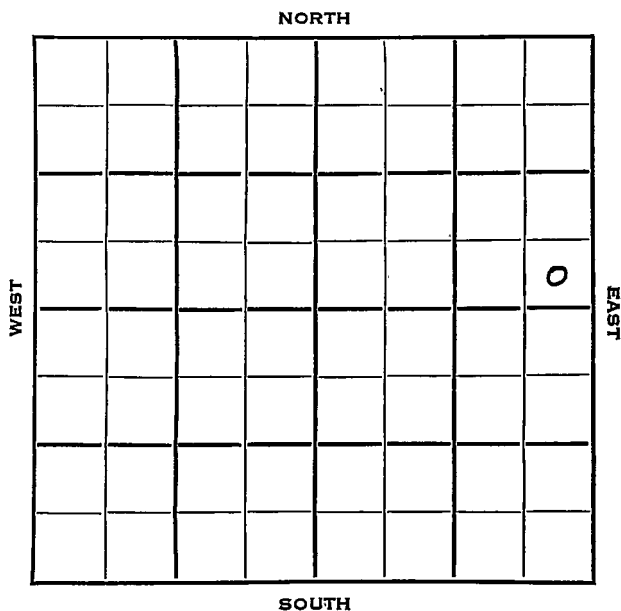


Section 28 Township 23 Range 14WWell No. 1 C. CadmanCompany Greenland Drlg.

NOT FILE		Stafford	KANSAS
SEC. 28	TRAMP.	R.	14 W ✓

WELL NO. # 1 C. Cadman FARM

COMPANY

Greenland Drlg.

CONTRACTOR

Greenland


Wildcat

_____ Ft. from N. Line

330 _____ Ft. from S. Line

330 _____ Ft. from E. Line

_____ Ft. from W. Line

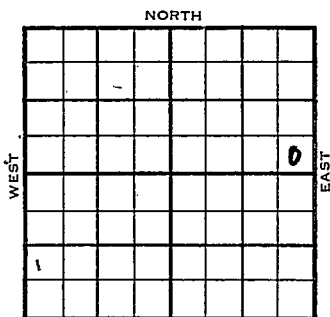

SE SE NE

MCPC has SW $\frac{1}{4}$ & W $\frac{1}{2}$ W $\frac{1}{2}$ Se of 34

Stanolind-DHM

	ELEVATION	REPORT
1953	1957'	
11/4	Spud 10-29-53 8 " @ 210 Drlg. 2730'	
11/12	Heeb 3438' Br. lime 3573', Lans 3583' DST 3710-17, open 1 hr, gas in 3 min, rec 60' froggy heavy oil, 15' HOCM, 1450# Cong 3912' Viola 3923' Simp 4015' Arb. 4080' TD 4110' 5" @ 3747' WOCT (Ltr-McGehee)	
11/19	CO to 3735' Elec log. 43/3703-10 FU 45' oil (Ltr-McGehee)	
11/25	1000 A F/90 BF 3 hr. F/30 BOPH Shut in for tanks. (Ltr-Gilstrap)	
12/9	F 30 BOPH 2" tub, SI Tanks	
12/16	N.R.	
1954		
1/6	"	
1/13	"	
1/20	"	
1/27	"	
2/3	"	
2/10	"	

1954

2/17 N.R.

2/24 "

3/3 "

3/10 "

3/17 "

3/24 Spud 10-29-53 Oil well TD 4110
8" @ 210 Heeb 3438 Br. lime 3573
Lans. 3583

DST 3710-17 open 1 hr gas in 3 min
rec 60' froggy heavy oil, 15' HOCM
1450# Cong. 3912 Viola 3923

Simp. 4015 Arb. 4080 TD 4110
5" @ 3747 CO to 3735 43/3703-10


FU 45' oil 1000 A F/90 BF 3 hr.

F/30 BOPH P/7 BOPD 220 BO in Jan.

Comp. 7 BOPD (Think they will plug.)

COMPLETED

County Stafford State Kans.
 Sec. 28 (Blk. 23 (Sur. 14W Map No.
 Operator Greenland Drlg.
 Well No. 1 Farm C. Cadman
 Elev. 1957 Location SE SE NE

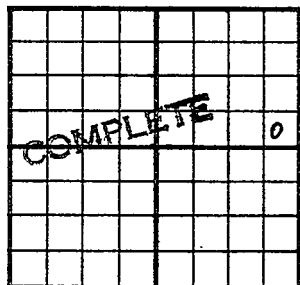

330 Ft. From S Line NE

330 Ft. From E Line Quarter

1st. Report

Completion MAR 24 1954

Remarks Wildcat

Greenland - Contr.

Spudding Date 10-29-53

Drlg. Data Oil well TD 4110

8" @ 210 Heeb. 3438 Br. lime 3573

Lans. 3583 DST 3710-17 open 1 hr.

gas in 3 min. Rec. 60' froggy heavy oil

15' hocm 1450# Cong. 3912 Viola 3923

Simp. 4015 Arb. 4080 TD 4110

5" @ 3747 CO to 3735 43/ 3703-10

FU 45' oil 1000 A F/ 90 bf 3 hr.

F/ 30 boph P/ 7 bopd 220 bo in Jan.

Comp. 7 bopd (Think they will plug)

J. G. McGEHEE