

KANSAS

Seward

FORM 51 IOM 12-46 PETROL


Section 28 Township ~~33~~ 23 Range 34-WWell No. 1 Garden City "D"Company Cities Service

Hugoton

NORTH

WEST

EAST

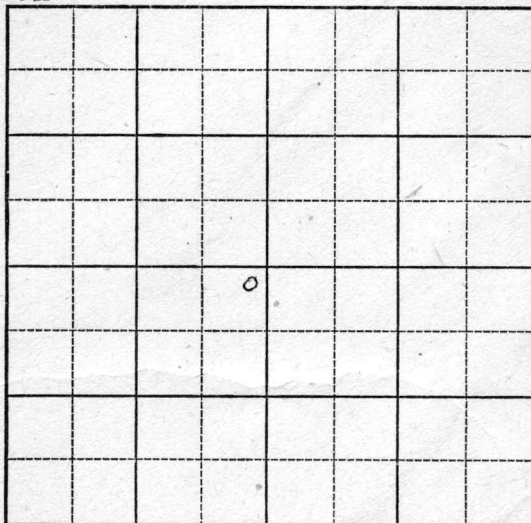

SOUTH

KANSAS

Seward
Finney

Sec. 28 Twp. 23 R. 34W

Well No. #1 Garden City "D" Farm

Cities Service Company

Hugoton


100 Ft. from N. Line

 Ft. from S. Line

100 Ft. from E. Line

 Ft. from W. Line

NE SW

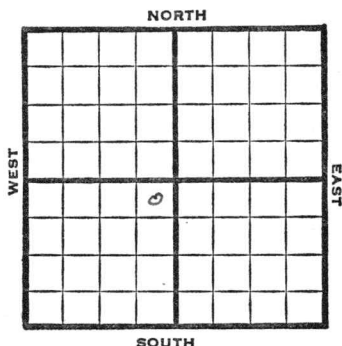

1947

Elev. 2971 REPORT

8/6	Location
8/20	"
8/27	"
9/3	8" @ 760' Drlg. 1065'
9/10	TD 2680' 5" @ 2678' 680 shots 2592'-2628'
9/17	160 shots 2478-2510' 8000 acid 120 shots. 2530-54' 14,500 acid.
9/24	10,500 acid.
10/1	"
10/8	5" @ 2679' Perf. 39,000 Acid 7,450,000 Gas TD 2680' 403# R Pr.

COMPLETED

Kansas Hugoton

Map No. _____ Sec. 28 Twp. 33 R. 34WWell No. 1 Garden City "D"

Cities Service

Company

FIRST REPORT

Contractor

NE SW

SECTION PLAT

	0		

100 Ft. from N. Line

Ft. from S. Line

100 Ft. from E. Line

Ft. from W. Line

Seward
Finney CountyLocation X

Rig up _____

Drilling and Remarks:

RECORD

Cased _____ in., _____ ft.

Sand _____

Gas _____

Oil _____

Total Depth _____

PRODUCTION

1st 24 hrs. Nat. _____

1st 24 hrs. after shot _____

Gas _____ Cu. Ft.

Dry Hole _____

Abandoned _____

Date

AUG 6 1947 19S. J. LEWIS

Scout

Map No. 0 Sec. 28 Twp. 23 R. 34W

Well No. 1 Garden City "D"

Cities Service

Company

CORRECTION

Contractor

NE SW

SECTION PLAT

100 Ft. from N. Line

 Ft. from S. Line

100 Ft. from E. Line

 Ft. from W. Line

Finney County

Location

Rig up

Drilling and Remarks:

Reported

28-33-34W

RECORD

Cased in., ft.

Sand

Gas

Oil

Total Depth

PRODUCTION

1st 24 hrs. Nat.

1st 24 hrs. after shot

Gas Cu. Ft.

Dry Hole

Abandoned

Date

AUG 13 1947


19

S. J. LEWIS

Scout

Map No. 0 Sec. 28 Twp. 23 R. 34WWell No. 1 Garden City "D"Cities Service CompanyCOMPLETE Contractor

NE SW

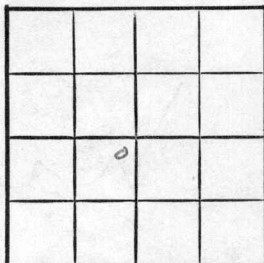E1.2971
SECTION PLAT100 Ft. from N. Line Ft. from S. Line100 Ft. from E. Line Ft. from W. Line

Finney County

Location Rig up

Drilling and Remarks:

5' @ 2679Perf.39000 Prod7,450,000 Gas403 # R / 2

RECORD

Cased in., ft.Sand Gas Oil Total Depth 2680

PRODUCTION

1st 24 hrs. Nat. 1st 24 hrs. after shot Gas Cu. Ft.Dry Hole Abandoned

Date

OCT 8 1947

19

S. J. LEWIS

Scout