

KANSAS


Kearny county

FORM 51 5M 6-46 PETROL

Section 28 Township 23 Range 35-W

Well No. #1, Miller "J"

Company Cities Service Oil Company

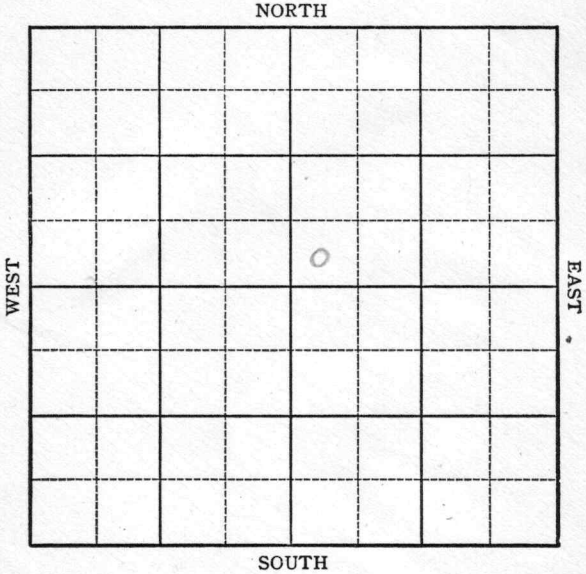

Sec. 28 Twp. 23 R. 35W

Well No. 1 Miller "J" Farm
Cities Service Company


Hugoton

_____ Ft. from N. Line

100 Ft. from S. Line

_____ Ft. from E. Line

100 Ft. from W. Line

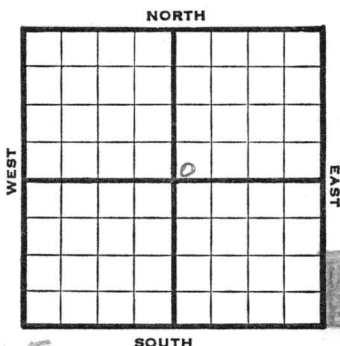

SW NE *HOT FILE*

REPORT	
1946	Elev. 3025'
11/20	RUR
11/27	8" @ 882' Drlg 1000'
12/3	TD 2675 5" @ 2673', RUST
12/10	" "
12/17	" "
1947	
1/2	110 shots 2574-94 150 s ots 2525-53 13500 acid
1/8	" " "
1/15	Total 27000 Acid
1/22	5" @ 2673' Perf 27000 Acid 3,420,000 Gas TD 2675' 418# RPR

COMPLETED

Map No. _____ Sec. 28 Twp. 23 R. 35W

Well No. 1 Miller "J"

Cities Service Company

FIRST REPORT Contractor

SW NE

SECTION PLAT

_____ Ft. from N. Line

100 Ft. from S. Line

_____ Ft. from E. Line

100 Ft. from W. Line

Kearny County

Location _____

Rig up _____

Drilling and Remarks:

R U R

RECORD

Cased _____ in., _____ ft.

Sand _____

Gas _____

Oil _____

Total Depth _____

PRODUCTION

1st 24 hrs. Nat. _____

1st 24 hrs. after shot _____

Gas _____ Cu. Ft.

Dry Hole _____

Abandoned _____

Date

NOV 20 1946 19

S. J. LEWIS Scout

Kansas KANSAS

Map No. _____ Sec. 28 Twp. 23 R. 35W

Well No. 1 Miller "J"

Cities Service _____ Company

COMPLETE

Contractor

SW NE

E1.3025

SECTION PLAT

_____ Ft. from N. Line

100 Ft. from S. Line

_____ Ft. from E. Line

100 Ft. from W. Line

		o	

Kearny County

Location _____

Rig up _____

Drilling and Remarks:

5102673
 Pref.
 27000 acid
 3,420,000 Gas
 418 # 2 1/2

RECORD

Cased _____ in., _____ ft.

Sand _____

Gas _____

Oil _____

Total Depth 2675

PRODUCTION

1st 24 hrs. Nat. _____

1st 24 hrs. after shot _____

Gas _____ Cu. Ft.

Dry Hole _____

Abandoned _____

Date

JAN 22 1947 19

S. J. LEWIS Scout