


Section 28 Township 23 Range 36 W

Well No. # 1 Ratzloff

Company Larion Oil & Gas

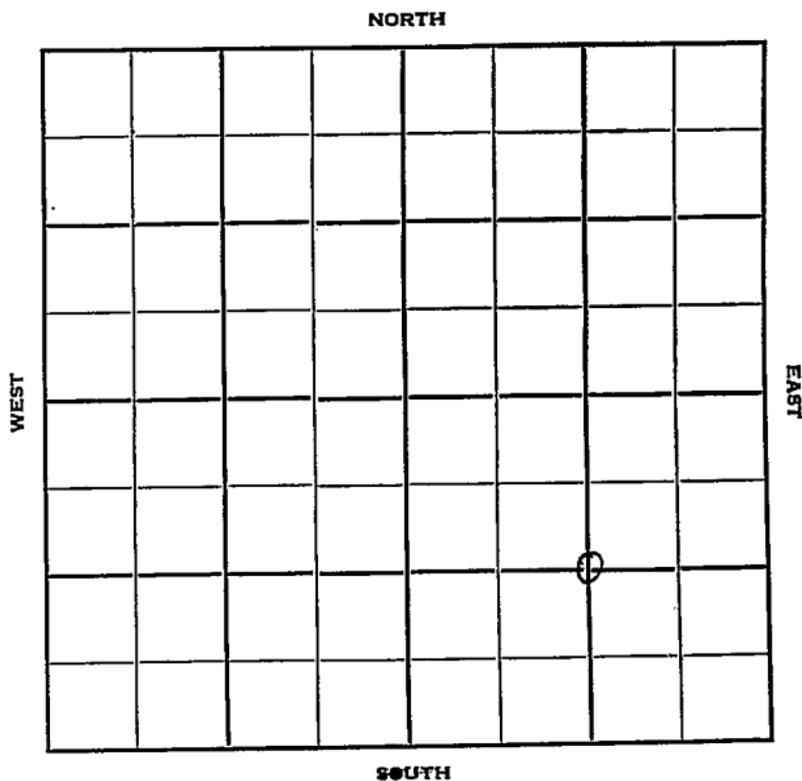

Kearny

KANSAS

Sec. 28 Twp. 23 R. 36 W

Well No. # 1 Ratzloff Farm

Lario Oil & Gas Company

Contractor

Hugoton Pool


_____ Ft. from N. Line

1320 Ft. from S. Line

1320 Ft. from E. Line

_____ Ft. from W. Line

C SE

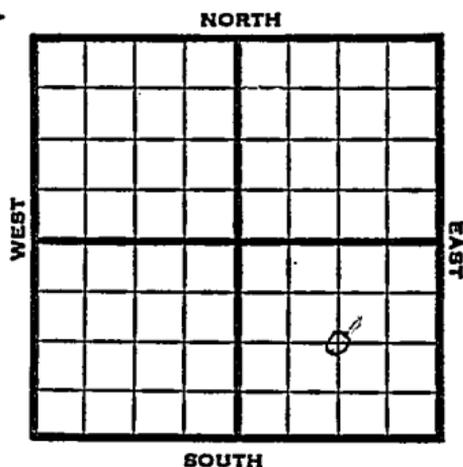

1951

Elev. 3214' REPORT

6/27

Spud 6-15-51

10" @ 812'

RTD 2613'

7" @ 2610'

8/1

Spud 6-15-51

Gas Well TD 2698

10" @ 812

7" @ 2610

TD 2698

Krider 2615 Ft. Riley 2683

22,500 A Comp. 11,426,000 gas

419#

COMPLETED

County Kearny State Kansas

Sec. 28 (Blk. Twp.) 23 (Sur. Rge.) 36W Map No.

Operator Tario Oil & Gas

Well No. 1 Farm Ratzloff

Elev. _____ Location C SE

FIRST REPORT					

1320 Ft. From S Line SE

1320 Ft. From E Line Quarter

1st. Report JUN 27 1951

Completion _____

Remarks _____

Spudding Date 6-15-51

Drlg. Data Hugoton Pool

10" @ 812 RTD 2613 7" @ 2610

J. E. TYRA

County Kearny State Kansas

Sec. 28 (Blk. 23) (Sur. 36W) (Twp.) (Rge.) Map No.

Operator Lario Oil & Gas

Well No. 1 Farm Ratzloff

Elev. 3214 Location C SE/4

1320 Ft. From S Line SE

1320 Ft. From E Line Quarter

Ist. Report

Completion AUG 1 1951

Remarks Hugoton Pool

Spudding Date 6-15-51

Drlg. Data Gas well TD 2698

10" @ 812 7" @ 2610 TD 2698

Krider 2615 Ft. Riley 2683 22500 A

Comp. 11,426,000 gas 419#

J. E. TYRA