


Section 28 Township 23 Range 37W

Well No. 1 Swain Gas Unit

Company Stanolind

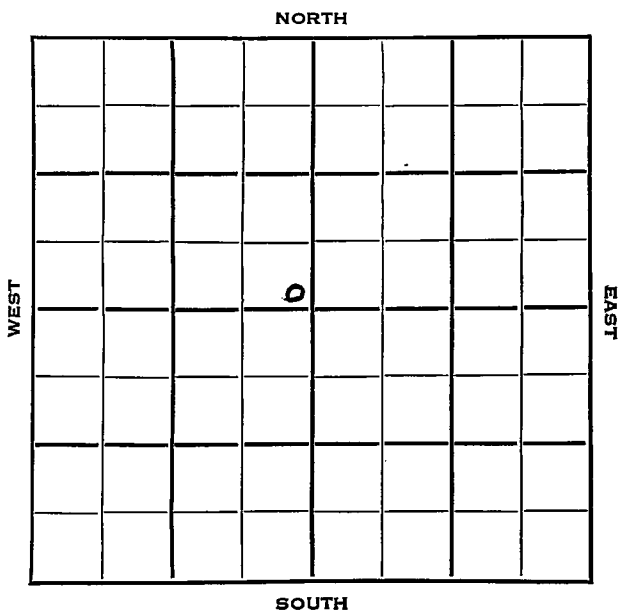

Kearny KANSAS

SEC.	TWP.	R.
28	23	37W ✓

WELL NO. **1 Swain Gas Unit** FARM

COMPANY **Stanolind**

CONTRACTOR


Hugoton Pool

_____ Ft. from N. Line

150 Ft. from S. Line

150 Ft. from E. Line

_____ Ft. from W. Line

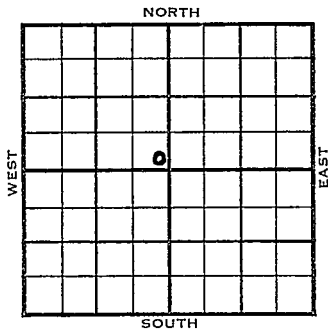

SE SE NW

	ELEVATION	REPORT
1954	3291'	

5/5 Location
 5/12 Drlg 484'
 6/30 Spud 5-9-54
 Gas Well
 TD 2726'
 8-5/8" @ 730'
 Her-Kri 2548', Win 2595', Tow 2658',
 Ft. Riley 2699'
 TD 2726'
 5 1/2" @ 2699'
 CO to 2716'
 90/2550-65, 54/2601-10, 36/2616-22,
 30/2642-47, 114/2663-82
 CO to 2726
 671,000 gas, frac
 Comp. 4,630,000 cfgpd 360#
COMPLETED

~~ACCOMPLISHED~~

