


Section 28 Township 23 Range 38 W

Well No. #1 Lindner

Company Stanolind

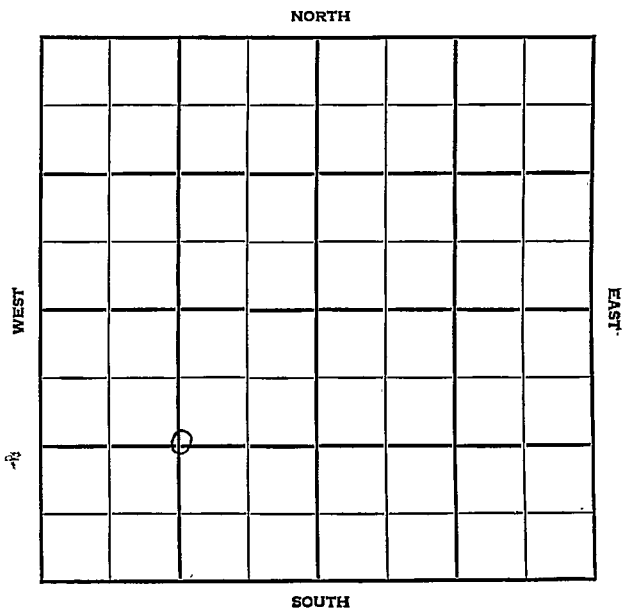

Kearny

KANSAS

| | | | | | |
|------|----|------|----|----|-----|
| SEC. | 28 | TWP. | 23 | R. | 38W |
|------|----|------|----|----|-----|

WELL NO. #1 Lindner FARM

COMPANY Stanolind

CONTRACTOR


Hugoton

_____ Ft. from N. Line

_____ Ft. from S. Line

_____ Ft. from E. Line

_____ Ft. from W. Line

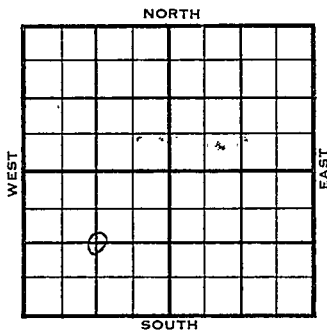

C SW/4

| | | | | |
|------|-----------|---------|---------|--------|
| 1955 | ELEVATION | 3326 RB | 3323 DF | REPORT |
|------|-----------|---------|---------|--------|

8/24 Location

10/19 Comm 9-1-55
 8 5/8" @ 838/500
 5 1/2" @ 2698/1000
 Herr 2564
 Wini 2618
 Tow 2678
 CO to 2696 36/2684-90 8/2668-70
 64/2658-66 frac 134 mcfg SP 2646
 36/2616-25' 24/2632-38 frac 1,700
 mcfg 80 gwph CO to 2700
 Comp 3,697 mcfgpd 328#

COMPLETED

County **Kearny** Elev. **3326 RB**
3323 DR
 Sec. **28** Twp. **23** Rge. **38W**
 Company **Stanolind**
 Farm Name **Lindner** No. **1**

| TOPS | DEPTH | LOG | DATUM | Loc. in Sec. | | | | | | | | | | | | |
|--------------|-------|-----|-------|---|--|--|--|--|--------------|--|--|--|-------------|--|--|--|
| Anh. | | | | C SW/4 | | | | | | | | | | | | |
| Tr. | | | | | | | | | | | | | | | | |
| Dg. | | | | Geol. | | | | | | | | | | | | |
| BL. | | | | | | | | | | | | | | | | |
| L. | | | | Contr. | | | | | | | | | | | | |
| K.C. | | | | | | | | | | | | | | | | |
| B.K.C. | | | | Pool | | | | | | | | | | | | |
| Ce. | | | | | | | | | | | | | | | | |
| C. | | | | Hugoton | | | | | | | | | | | | |
| M. | | | | | | | | | | | | | | | | |
| M. | | | | <table border="1"> <tr> <td></td> <td></td> <td></td> <td></td> </tr> <tr> <td colspan="4" style="text-align: center;">FIRST REPORT</td> </tr> <tr> <td colspan="4" style="text-align: center;">AUG 24 1955</td> </tr> </table> | | | | | FIRST REPORT | | | | AUG 24 1955 | | | |
| | | | | | | | | | | | | | | | | |
| FIRST REPORT | | | | | | | | | | | | | | | | |
| AUG 24 1955 | | | | | | | | | | | | | | | | |
| K. | | | | | | | | | | | | | | | | |
| Mz. | | | | | | | | | | | | | | | | |
| Me. | | | | | | | | | | | | | | | | |
| V. | | | | | | | | | | | | | | | | |
| S. | | | | | | | | | | | | | | | | |
| S. | | | | | | | | | | | | | | | | |
| A. | | | | | | | | | | | | | | | | |
| R. | | | | | | | | | | | | | | | | |
| PE. | | | | | | | | | | | | | | | | |
| G. | | | | | | | | | | | | | | | | |
| T.D. | | | | | | | | | | | | | | | | |

Date Comm. _____

Location _____

Handwritten signature/initials

Co.
Lse.
No.
Sec.
T.
R.

3326 RB

County Keany

Elev. 3323 DF

Sec. 28 Twp. 23

Rge. 38W

Company Stanolind

Farm Name Lindner

No. 1

| TOPS | DEPTH | LOG | DATUM |
|-------------------|-------------|-----|-------|
| Anh. <u>Herr.</u> | <u>2564</u> | | |
| Tr. <u>Winn</u> | <u>2618</u> | | |
| H. <u>MAN.</u> | <u>2678</u> | | |
| Tr. | | | |
| Dg. | | | |
| Bl. | | | |
| L. | | | |
| K.C. | | | |
| B.K.C. | | | |
| Ce. | | | |
| C. | | | |
| M. | | | |
| M. | | | |
| K. | | | |
| Mz. | | | |
| Me. | | | |
| V. | | | |
| S. | | | |
| S. | | | |
| A. | | | |
| R. | | | |
| Pe. | | | |
| G. | | | |
| T.D. | | | |

Loc. in Sec. C SW/4

Geol. _____

Contr. _____

Pool

Hugoton

COMPLETE

Date Comm. 9-1-55

OCT 1 9 1955

8 5/8" @ 838/500 5 1/2" @ 2698/1000

CO to 2696 36/ 2684-90 8/ 2668-70

6 1/4/ 2658-66 frac 13 1/4 mcf/g SP 2646

36/ 2616-25 2 1/4/ 2632-38 frac

1,700 mcf/g 80 gwph CO to 2700

Comp. 3,697 mcf/gpd 328#