

Map No. KANSAS Sec. 27 Twp. 20 R. 1

Well No. 1 - 1906 Farm

Mrs. Gay Oil Company

NORTH

[illegible]

SOUTH

Location.....

Drilling Remarks

Rig Up.....

Drilling Remarks

RECORD

Cased.....in.....ft.

Sand.....

Gas.....

Oil.....

Total Depth.....

PRODUCTION

1st 24 hrs. Nat.....

1st 24 hrs. after shot.....

Gas.....cu. ft.....


Dry Hole.....

Abandoned.....

Harvey
A-5M-5-28-Mid-West

Map No. **KANSAS** Sec. **29** Twp. **23** R. **1^W**
Well No. **1 - Grove** Farm
Mrs Gay Oil Company

330 Ft. from N. Line
Ft. from S. Line
990 Ft. from E. Line
Ft. from W. Line

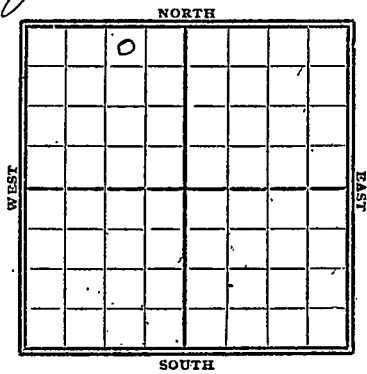

1928

Date	REPORT
11/28	Ro.G.
12/5	Bldg Rig
12/12	Rig
12/19	
12/26	Rigged up & S.D.
1929	
1/2	
1/9	Spud
1/16	
1/23	run 15" - 384'
1/30	drlg 700'
2/6	show gas 1005'
	show oil 1012'
	drlg 1040'
2/13	" 1255' 12" - 1243'
2/20	drlg 2030'
2/27	S.D. 2100' - T.D.
3/6	—
3/13	—
3/20	—
3/27	—
4/3	—

4/10 - T.D. 2100' - S.D.
4/17 —
4/24 - T.D. 2100' To startup
5/1 - 10" - 2090 nrlg 2130'
5/8 - no report
5/15 - nrlg 2550'
5/22 - " 2720'
5/29 —
6/5 - 6" 2930
6/12 - show oil 3008-12-S.D.
6/19 —
6/26 —
7/2 —
7/10 —
7/17 —
7/24 —
7/31 —
8/7 —
8/14 —
8/21 —
8/28 —
9/4 - W.R. 6" - 3012
9/11 - no report
9/18 —
9/25 - 2" mass line 3015
HFW 3202-28
nrlg 3295
10/2 - S.D. 3295'
10/9 —
10/16 —
10/23 —
10/30 —
11/6 - S.D. 3360' Base line
11/13 — 12/11 — 12/30 —
11/20 — 12/18 — 1/30 —
11/27 — 12/23 — 1/18 —
12/4 — 12/23 — 1/15 —

Map No. Rd Sec. 29 Twp. 23 R. 1^WWell No. 1 - Grove FarmMrs. Day Oil Company

NORTH

330 Ft. from N. Line Ft. from S. Line990 Ft. from E. Line Ft. from W. Line

WEST

EAST

SOUTH

Date

REPORT

1/22

Base line 3360'
S.D. 3360'

1/29

—

2/5

—

2/12

—

2/19

Rigging up.

2/26

S.D.

3/5

—

3/12

—

3/19

—

3/26

—

4/2

h. O. l. g. 3414

4/9

" 3556

4/16

S.D. 3614

4/23

T.D. 3630

Dry & Abandon

Map No. 11423
 MAP NO. 11423 SEC. 29 TWP. 23 R. 14

WELL NO. 1 Grove

Mrs Gay Oil COMPANY

CONTRACTOR

SECTION PLAT

	0		

330 FT. FROM N. LINE

FT. FROM S. LINE

990 FT. FROM E. LINE

FT. FROM W. LINE

FIRST REPORTS

RECORD

LOCATION _____

CASED _____ IN. _____ FT.

RIG UP _____

SAND _____

DRILLING AND REMARKS:

GAS _____

OIL _____

TOTAL DEPTH _____

PRODUCTION

1ST 24 HRS. NAT. _____

1ST 24 HRS. AFTER SHOT _____

GAS _____ Cu. Ft.

DRY HOLE _____

ABANDONED _____

DATE

NOV 28 1928

S. J. LEWIS

SCOUT

Harvey
 Map No. **KANSAS** Sec. *29* Twp. *23* R. *1W*
39
 Well No. *George*

Mrs. Gay Oil Company
 Contractor

SECTION PLAT

330 Ft. from N. Line

_____ Ft. from S. Line

990 Ft. from E. Line

_____ Ft. from W. Line

ABANDONED

	0		

Location _____

Rig up _____

Drilling and Remarks: _____

RECORD

Cased _____ in., _____ ft.

Sand _____

Gas _____

Oil _____

Total Depth *39630*

PRODUCTION

1st 24 hrs. Nat. _____

1st 24 hrs. after shot _____

Gas _____ Cu. Ft.

Dry Hole _____

Abandoned _____

Date

APR 23 1930

S. J. LEWIS Scout