

KANSAS

Reno


FORM 51 5M 4-41 PETROL

Section 29 Township 23 Range 10-W

Well No. #1 Wyss

Company Cities Service Oil

NORTH Peace Creek Pool

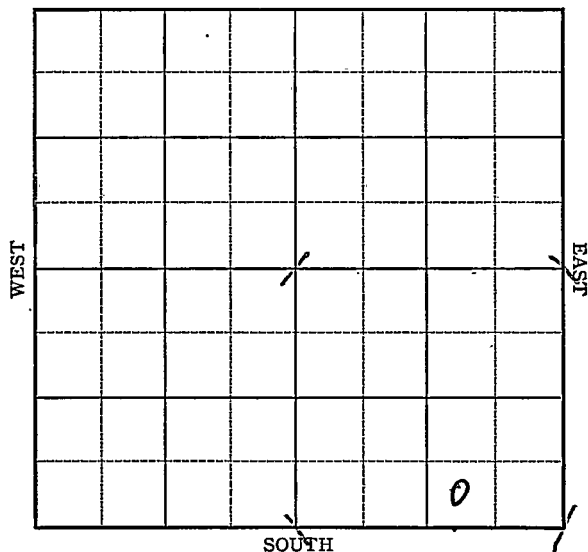


KANSAS

Reno

Sec. 29 Twp. 23 R. 10-WWell No. #1 Wyss FarmCities Service Oil Company

(Peace Creek)

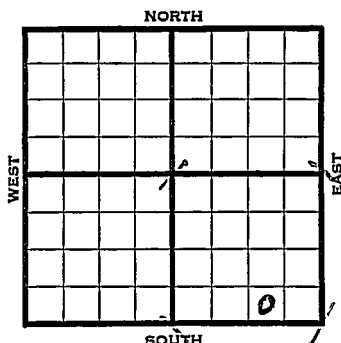 Ft. from N. Line330 Ft. from S. Line990 Ft. from E. Line Ft. from W. Line*Elw. 1785*


1942	REPORT
6/3	8" - 161' WOC.
6/10	Drlg. 3109'
6/17	Viola 3649' Arb. 3774' T.D. 3812'
	stains. 5" - 3812' RUST.
6/24	Drill plug to 3800'
	5 shots 3768-72' no shows.
	7 shots 3774-80' S.W. 5 shots 3780 to
	3784' Water. P.B. to 3754' WOC.
7/1	" " "
7/8	Viola 3649'
	Arb. 3774'
	5" - 3812'
	T.D. 3812'
	12 shots 3774-84'
	Water.
	ABANDONED

Reno

Map No. 47 Sec. 29 Twp. 23 R. 10WWell No. 1 WyssCities Service Oil CompanyFIRST REPORT Contractor

SW SE SE

SECTION PLAT

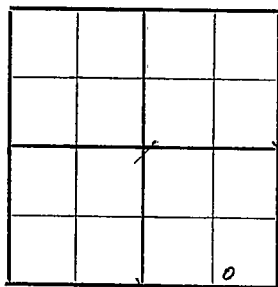 Ft. from N. Line330 Ft. from S. Line990 Ft. from E. Line Ft. from W. Line

PEACE CREEK POOL

Location Rig up

Drilling and Remarks:

8" - 161'

Waiting on
cement to set

RECORD

Cased in., ft.Sand Gas Oil Total Depth

PRODUCTION

1st 24 hrs. Nat. 1st 24 hrs. after shot Gas Cu. Ft.Dry Hole Abandoned

Date

JUN 3 1942 19 S. J. LEWIS Scout

Reno

Map No. 47 Sec. 29 Twp. 23 R. 10WWell No. 1 Wyss

Cities Service Oil Company

ABANDONED

Contractor

SW SE SE


SECTION PLAT

Ft. from N. Line

330 Ft. from S. Line990 Ft. from E. Line

Ft. from W. Line

PEACE CREEK POOL

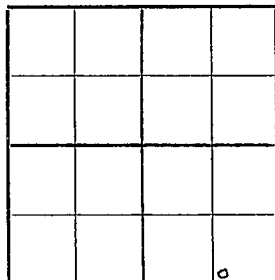

Location

Rig up

Drilling and Remarks:

*✓ 10-12 3649**OK & 3774**5" 3812**12 sh to 3774-84**Water*

RECORD

Cased _____ in., _____ ft.

Sand _____

Gas _____

Oil _____

Total Depth 3812

PRODUCTION

1st 24 hrs. Nat. _____

1st 24 hrs. after shot _____

Gas _____ Cu. Ft.

Dry Hole _____

Abandoned _____

Date

JUL 8 1942 19

S. J. LEWIS Scout