


Section 29 Township 23 Range 12-W

Well No. #1 W E Crane

Company Skelly

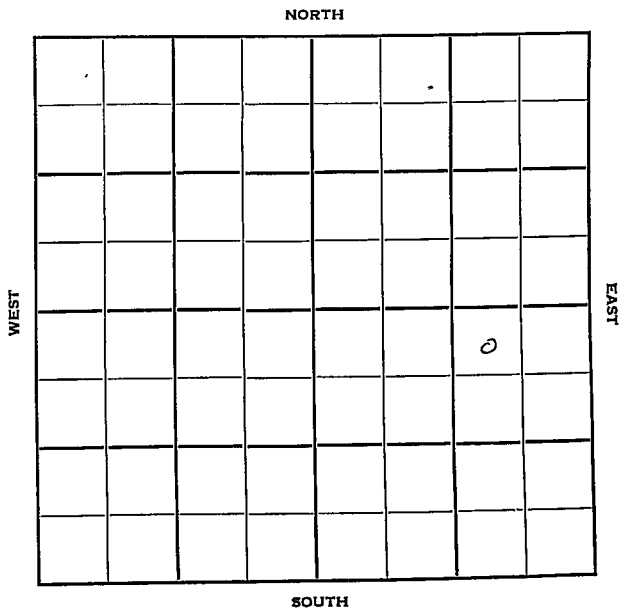

Sec. 29 Twp. 23 R. 12W ✓

Well No. #1 W.E. Crane Farm

Skelly Company

Contractor


330' Ft. from N. Line

_____ Ft. from S. Line

990' Ft. from E. Line

_____ Ft. from W. Line

NW NE SE

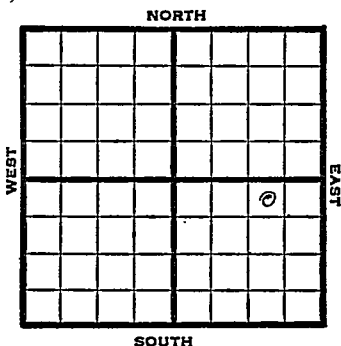

1950

Elev 1866'

REPORT

3/8
4/12

Location
TD 3865'
8" @ 698'
Lans 3416'
Cong 3701'
Viola 3735'
Simp 3792
Simp Sd 3821-27'
Arb. 3855'
5" @ 3856'
5264 BOPD
Comp

	✓	S
	3735	3855
	1866	1866
	1869	1989

COMPLETED

Kansas

Map No. _____ Sec. 29 Twp. 23 R. 12W

Well No. 1 W. E. Crane

Skelly Company

Contractor

NW NE SE Mid-Continent owns NW - 30

SECTION PLAT

330 Ft. from N. Line

_____ Ft. from S. Line

990 Ft. from E. Line

_____ Ft. from W. Line

			o

FIRST REPORT

Stafford County

Location x

Rig up _____

Drilling and Remarks:

RECORD

Cased _____ in., _____ ft.

Sand _____

Gas _____

Oil _____

Total Depth _____

PRODUCTION

1st 24 hrs. Nat. _____

1st 24 hrs. after shot _____

Gas _____ Cu. Ft.

Dry Hole _____

Abandoned _____

Date

MAR 8 1950 19

J. E. TYRA

Scout

Map No. _____ Sec. 29 Twp. 23 R. 12W

Well No. 1 W. E. Crane

Skelly Company

Contractor

NW NE SE

E. 1866
SECTION PLAT

330 Ft. from N. Line

_____ Ft. from S. Line

990 Ft. from E. Line

_____ Ft. from W. Line

COMPLETE			
			0

Stafford County

Location _____

Rig up _____

Drilling and Remarks:

8" @ 698
Sans 3416
Cang 3701
Viola 3735
Simp 3792
Semp sd 3821-27

RECORD

Cased _____ in., _____ ft.

Sand _____

Gas _____

Oil _____

Total Depth 3865

PRODUCTION

1st 24 hrs. Nat. _____

1st 24 hrs. after shot _____

Gas _____ Cu. Ft.

Dry Hole _____

Abandoned _____

Date *(ans)*

APR 12 1950

J. E. TYRA

Art 3855

5" @ 3856

UNIT NO. _____

5264 BOPD

RECEIVED

NAME OF UNIT _____
 NAME OF LEADER _____
 ADDRESS _____
 CITY _____

FRONT _____
 BACK _____
 CASE _____
 NO. _____

- Scout Cards _____
- Land Small Map _____
- Land Wall Map _____
- Tracings _____
- France Map _____
- Pierce Map _____
- Misc. _____

APR 21 1950

Edith