

KANSAS


FORM 51 25M 3-49 PETROL

Stafford

Section 29 Township 23 Range 12-W

Well No. #2 Riley

Company Skelly Oil

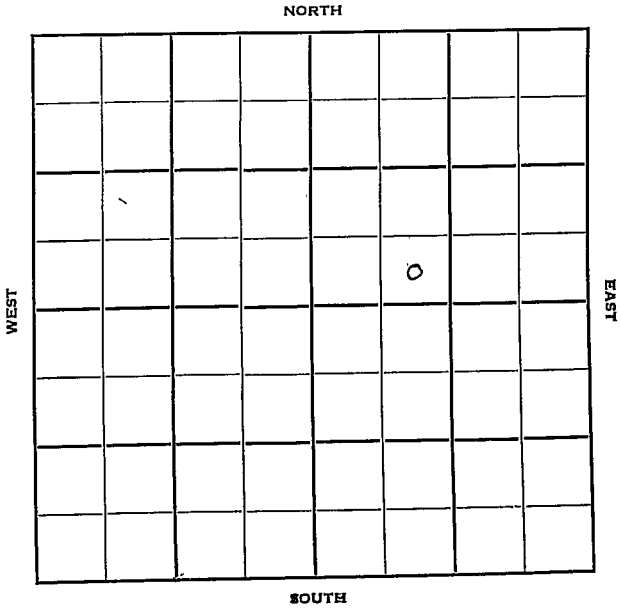

Stafford **KANSAS**

Sec. 29 Twp. 23 R. 12W

Well No. #2 Riley Farm

Skelly Oil Company

Wentworth - Contr. Contractor

Bedford Pool


Ft. from N. Line

330' Ft. from S. Line

Ft. from E. Line

990' Ft. from W. Line

SE SW NE

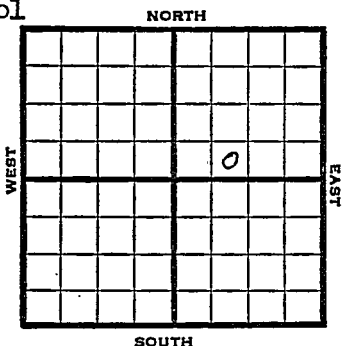

1950

Elev. 1870' REPORT

9/6 Location

10/4 Spud 9-10-50  
 Oil Well TD 3860'  
 Anhy 672' 8" @ 681'  
 Heeb 3235'  
 Toronto 3265' Doug 3283'  
 Br Lime 3383 Lans. 3417'  
 Cong. 3696' Viola 3729'  
 Simp. Sh 3793' Arb. 3855-60  
 5" @ 3856'  
 TD 3860' S/99 BO 4 BW 2 hr.  
 S/46 BO 2 BW 3 hr. Comp. 116 BOPD

COMPLETED



