


Section 29 Township 23 Range 12-W

Well No. #1 Zepha E. Riley

Company Skelly

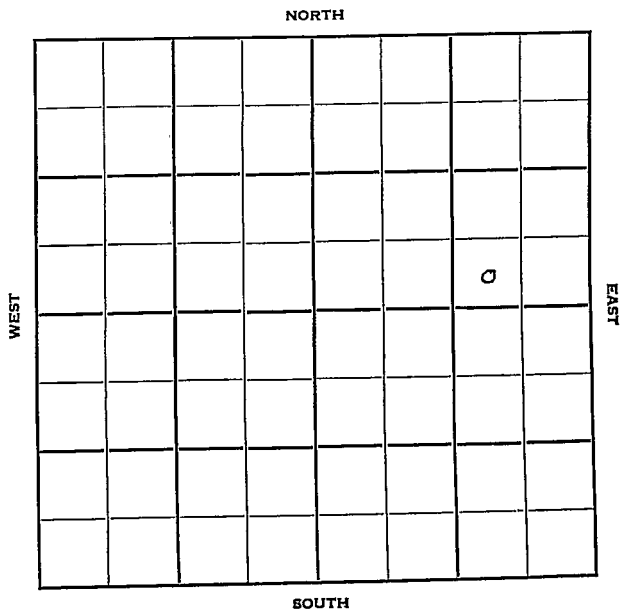

Sec. 29 Twp. 23 R. _____

Well No. #1 Zepha E. Riley Farm _____

Skelly Company _____

Contractor Bedford Pool


_____ Ft. from N. Line

330' Ft. from S. Line

990' Ft. from E. Line

_____ Ft. from W. Line

SW SE NE

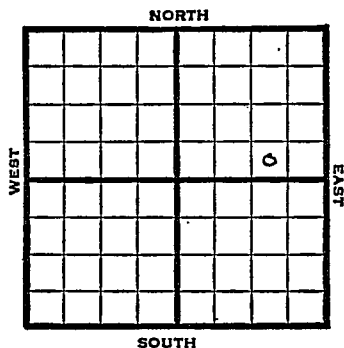

1950 Elev 1864 REPORT

6/28 Spud 6-23-50
Anhy 670'
8" @ 678'
WOC

7/19 Anhy 670 Doug 3280
Br lime 3382 Lans 3410
Cong 3687 Viola 3723
Simp 3781 Arb 3851
5" @ 3851
TD 3855
2150' oil 4 hr
S/156 bo 4 hr 700' off bottom
~~XXXXXXXXXXXX~~
Comp 163 bo 74 bwpd
Completed

3723
1864

1859

COMPLETED

Map No. _____ Sec. 29 Twp. 23 R. 12W

Well No. 1 Zepha E. Riley

Skelly

Company

Contractor

SW SE NE

SECTION PLAT

_____ Ft. from N. Line


330

Ft. from S. Line

990

Ft. from E. Line

_____ Ft. from W. Line

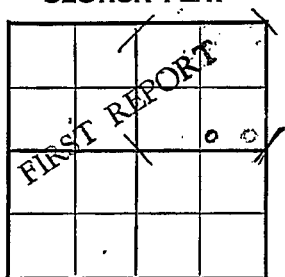

Stafford County

Location _____

Rig up _____

Drilling and Remarks:

Spud 6-23-50

Anhy 670

8" C 678

WOC

RECORD

Cased _____ in., _____ ft.

Sand _____

Gas _____

Oil _____

Total Depth _____

PRODUCTION

1st 24 hrs. Nat. _____

1st 24 hrs. after shot _____

Gas _____ Cu. Ft.

Dry Hole _____

Abandoned _____

Date

JUN 28 1950 19

J. E. TYRA Scout

~~Lansda~~

Map No. _____ Sec. 29 Twp. 23 R. 12W

Well No. 1 Zepha E. Riley

Skelly _____ Company

_____ Contractor

SW SE NE


E1. 1864
SECTION PLAT

_____ Ft. from N. Line

330 Ft. from S. Line

990 Ft. from E. Line

_____ Ft. from W. Line

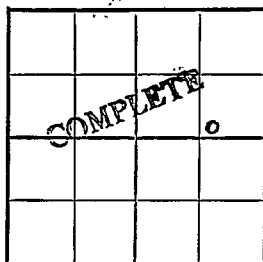

Stafford County

Location _____

Rig up _____

Drilling and Remarks:

Anhy 670

Doug. 3280

Br. lime 3382

Lans. 3410

Cong. 3687

Viola 3723

Simp. 3781

RECORD

Cased _____ in., _____ ft.

Sand _____

Gas _____

Oil _____

Total Depth 3855

PRODUCTION

1st 24 hrs. Nat. _____

1st 24 hrs. after shot _____

Gas _____ Cu. Ft.

Dry Hole _____

Abandoned _____

Date JUL 19 1950

Arb. 3851

5" @ 3851

ED 3855

2150' oil. 4 hr.

S/ 156 bo 4 hr.

Comp. 163 74

Misc.
Pierce Map
France Map
Tracings
Land Wall Map
Land Small Map
Scout Cards

700

SEARCHED

SERIALIZED

INDEXED

FILED

SEARCHED