


Section 29 Township 23 Range 12-W

Well No. #2 Williamson

Company Skelly Oil

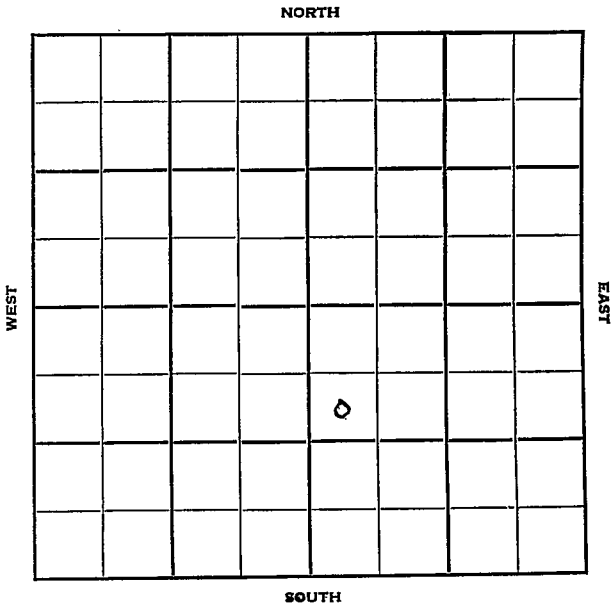

Sec. 29 Twp. 23 R. 12W

Well No. #2 Williamson Farm

Skelly Oil Company

Wentworth - Contr. Contractor

Bedford Pool


990' Ft. from N. Line

_____ Ft. from S. Line

_____ Ft. from E. Line

330' Ft. from W. Line

SW NW SE

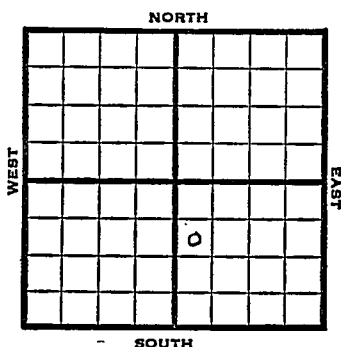

1950

Elev 1871 REPORT

11/8

Location

11/29

Spud 11-9-50

8" @ 685

Anhy 670

Heeb 3259

Toronto 3279

Douglas 3304

Br line 3398

Lans 3427

Cong 3710

Viola 3747

Simp 3811

Arb 3882

DST 3882-88 opn 1 hr rec 730' wtr

TD 3912

D&A

ABANDONED

