


Section 29 Township 23 Range 12-W

Well No. #1 Williamson

Company Skelly Oil

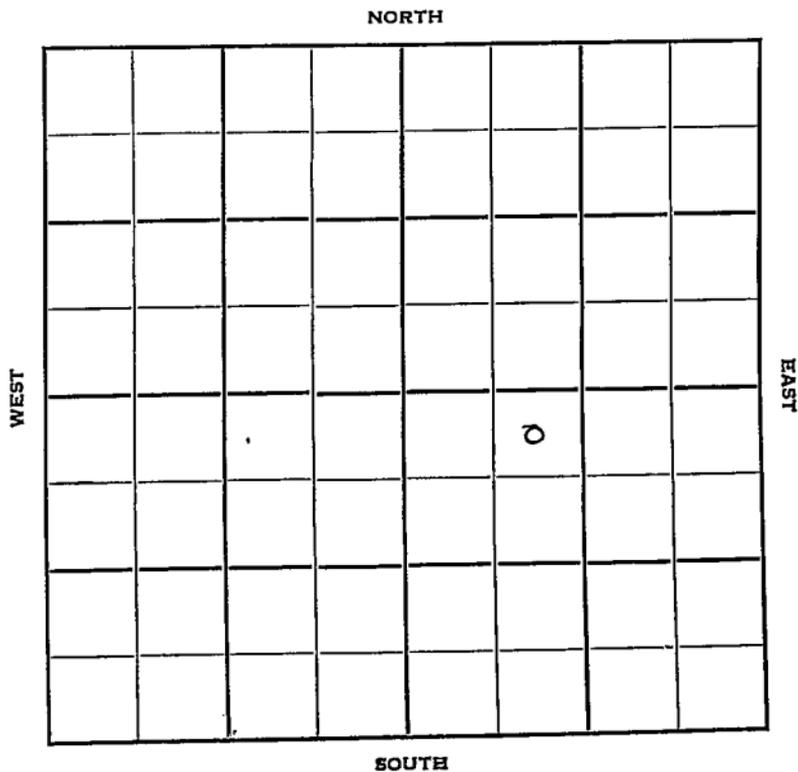

Sec. 29 Twp. 23 R. 12W

Well No. #1 Williamson Farm

Skelly Oil Company

Bedford Pool Contractor


330' Ft. from N. Line

\_\_\_\_\_ Ft. from S. Line

\_\_\_\_\_ Ft. from E. Line

990' Ft. from W. Line

NE NW SE

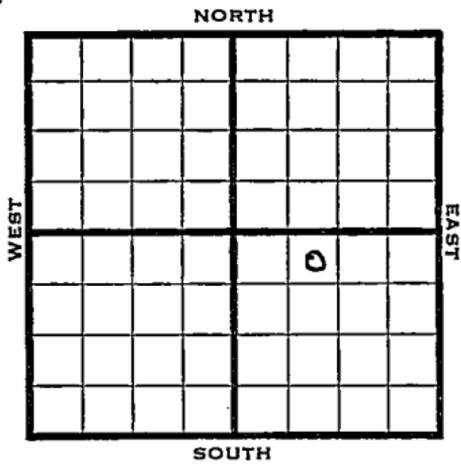

1950 Elev. 1870' REPORT

8/9 Spud 8-4-50  
Anhy 670'  
8" @ 680'  
WOC

9/13 Spud 8-4-50  
Oil Well TD 3867'  
Anhy 670'  
8" @ 680'  
Heeb 3246'  
Toronto 3266' Doug. 3284'  
Br. Lime 3386'  
Lans. 3414' Arb 3860-62'  
Cong. 3695'  
Viola 3731'  
Simp 3794'  
5" @ 3861'  
TD 3862'  
S/5 BOPH DD 3865'  
S/38 BOPH DD 3867'  
S/90 BO 3 hr.  
Comp. 168 BOPD

3731  
1870  
-1861

**COMPLETED**


County Stafford State Kansas

Sec. 29 (Blk. 23) (Sur. 12W) (Twp.) 23 Map No.

Operator Skelly Oil

Well No. 1 Farm Williamson

Elev. \_\_\_\_\_ Location NE NW SE

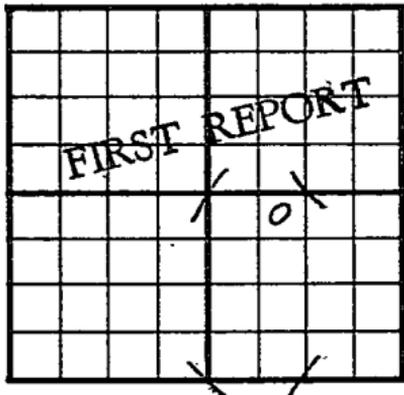

330 Ft. From N Line SE

990 Ft. From W Line Quarter

1st. Report AUG 9 1950

Completion \_\_\_\_\_

Remarks \_\_\_\_\_

Spudding Date 8-4-50

Drlg. Data Bedford Pool

Any 670 8" @ 680 WOC


County Stafford State Kansas

Sec. 29 (<sup>Blk.</sup>Twp.) 23 (<sup>Sur.</sup>Rge.) 12W Map No.

Operator Skelly Oil

Well No. 1 Farm Williamson

Elev. 1870 Location NE NW SE

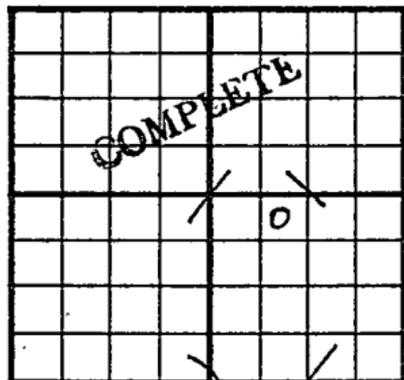

330Ft. From N Line SE

990Ft. From W Line Quarter

1st. Report

Completion SEP 13 1950

Remarks

Bedford Pool

Spudding Date 8-4-50

Drlg. Data Oil well TD 3867

Anhy 670 8" @ 680 Heeb. 3246

Toronto 3266 Doug. 3284 Br. line 3386

Lans. 3414 Cong. 3695 Viola 3731

Simp. 3794 Arb. 3860-62 5" @ 3861

TD 3862 S/ 5 boph & DD 3865 S/ 38 boph

DD 3867 S/ 90 ba 3 hr.

Comp. 168 bopd

J. E. TYRA