

Section 29 Township 23 Range 13WWell No. #1 BudgeCompany J. H. Johnson

			0				

NORTH

WEST

EAST

SOUTH

Sec. 29 Twp. 23 R. 13W

Well No. #1 Budge Farm

J. H. Johnson Company

Stearns Contractor


Wildcat

330 Ft. from N. Line

 Ft. from S. Line

330 Ft. from E. Line

 Ft. from W. Line

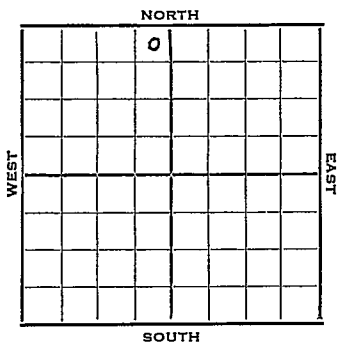

NE NE NW

Magnolia Farmout

Derby & CSO - DHM


1953 Elev. 1888' REPORT

2/25 Spud 2-19-53
8" @ 320
Anhy 807'
Drlg. 2215'

3/11 Spud 2-19-53 D & A TD 3970
8" @ 320 Anhy 807 Heeb 3340
Br line 3472 Lans 3499
DST 3555-71 open 1 hr. rec 450' SW
1190# Cong. 3804
DST 3612-28 open 1 hr. rec 80' mud &
wtr. 1170# Viola 3852' Arb. 3940
TD 3970' D & A

ABANDONED

County Stafford State Kansas
 Sec. 29 (Blk. Twp.) 23 (Sur. Rge.) 13W Map No.
 Operator J. H. Johnson
 Well No. I Farm Budge
 Elev. _____ Location NE NE NW

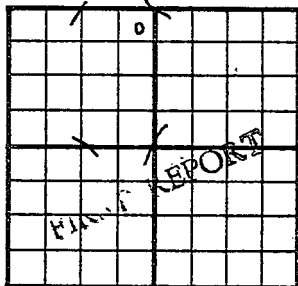


330 Ft. From N Line NW
330 Ft. From E Line Quarter
 Ist. Report FEB 25 1953

Completion _____
 Remarks Magnolia farmout
Derby & CSO - IHM
Stearns - Contr.

Spudding Date 2-19-53

Drlg. Data Wildcat
8" @ 320 Anhy 807 drig. 2215

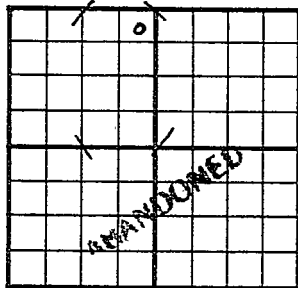County Stafford State KansasSec. 29 (Blk. 23) (Sur. 13W) Map No.Operator J. H. JohnsonWell No. 1 Farm BudgeElev. 1888 Location NE NE NW330 Ft. From N Line NW330 Ft. From E Line Quarter

1st. Report

Completion MAR 11 1953Remarks WildcatStearns - Contr.Spudding Date 2-19-53Drig. Data D & A TD 39708" @ 320 Anhy 807 Heeb. 3340Br. lime 3472 Lans. 3499 DST 3555-71open 1 hr. Rec. 450' sw 1290#Cong. 3804 DST 3612-28 open 1 hr.Rec. 80' mud & wtr. 1170# Viola 3852Arb. 3940 TD 3970D & A

—J. G. McGEHEE—