

M-AG

Stafford

FORM 51 5M PETROL

Section 29 Township 23 Range 13WWell No. #1 ZimmermanCompany Helmerich & Payne

Wildcat

NORTH

WEST

EAST

							0

SOUTH

KANSAS

Stafford

Sec. 29 Twp. 23 R. 13-W

Well No. #1 Zimmerman Farm

Helmerich & Payne Company


 Ft. from N. Line

330 Ft. from S. Line

330 Ft. from E. Line

 Ft. from W. Line

Elev. 1897

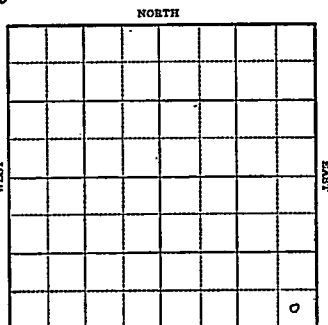

1943

R E P O R T

12-22 Derrick

12/29

1944

1-5

Drlg. 270'

1/12

10" @ 368

Drlg. 1800' ?

1/19

Lans 3536

Drlg. 3759'

1/26

BKC 2790

Cong 3858

Viole 3875

Arb 3999

TD 4040


ABANDONED

KANSAS

Map No. 73 Sec. 29 Twp. 23 R. 13WWell No. 1 ZimmermanHelmerich & Payne CompanyFIRST REPORT Contractor

SE/C

SECTION PLAT

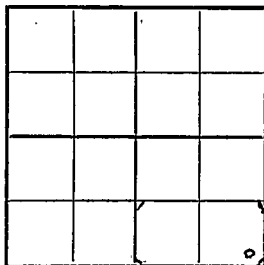 Ft. from N. Line330 Ft. from S. Line330 Ft. from E. Line Ft. from W. Line

Wildcat

Location Rig up

Drilling and Remarks:

Derrick

RECORD

Cased in., ft.Sand Gas Oil Total Depth

PRODUCTION

1st 24 hrs. Nat. 1st 24 hrs. after shot Gas Cu. Ft.Dry Hole Abandoned

Date

DEC 22 1943

19

S. J. LEWIS Scout

KANSAS

Map No. 83 Sec. 29 Twp. 23 R. 13WWell No. 1 ZimmermanHelmerich & Payne Company

ABANDONED

Contractor

SE/C

SECTION PLAT

Ft. from N. Line

330

Ft. from S. Line

330

Ft. from E. Line

Ft. from W. Line

Wildcat

Location

Rig up

Drilling and Remarks:


RECORD

Cased _____ in., _____ ft.

Sand _____

Gas _____

Oil _____

Total Depth 4040

PRODUCTION

1st 24 hrs. Nat. _____

1st 24 hrs. after shot _____

Gas _____ Cu. Ft.

Dry Hole _____

Abandoned _____

Date

JAN 26 1944 19

S. J. LEWIS Scout