
Stafford KANSAS

FORM 51

Section 29 Township 23 Range 11W

Well No. #1 Gilmore Est.

Company Natural Gas & Oil & Republic Nat.

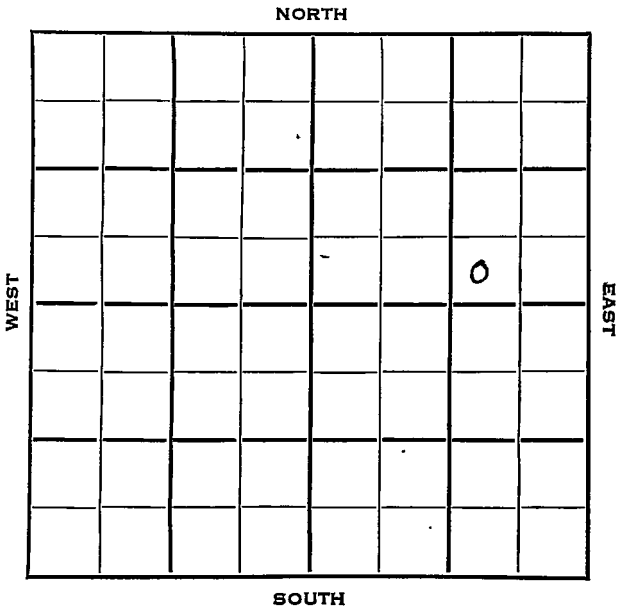

Stafford KANSAS

SEC.	TWP.	R.
29	23	14 W

WELL NO.

1 Gilmore Est. FARM

COMPANY

Natural Gas & Oil & Republic Nat.

CONTRACTOR

Co. tools

Wildcat


_____ Ft. from N. Line

330 Ft. from S. Line

990 Ft. from E. Line

_____ Ft. from W. Line

SW SE NE

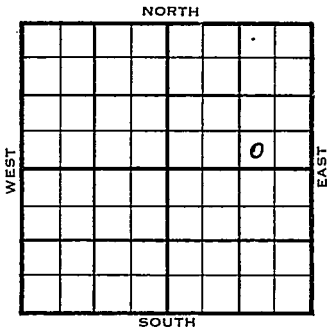

1954

ELEVATION 1966'

REPORT

1/20 Spud 1-15-54
8" @ 212
Drlg. 2035'

1/27 Anhy 875', Heeb 3466', Br. L. 3603'
Lans 3613'
DST 3789'-3835' 1 hr, 30' M 800#
Drlg 3873'

2/3 Spud 1-15-54
D & A
TD 4167'
8" @ 212'
Anhy 875', Heeb 3466', Br. Lime3603'
Lans3613'
DST 3789'-3835' opn 1 hr, rec 30' Mud 800# Simp 4029', Arb 4069'
DST 4033'-70' opn 1 hr, rec 570' sml wtr. 1275#
DST 4072'-95' opn 1 hr, rec 2940' sw 1450#
TD 4167'
D & A

ABANDONED

DX-78

FORM 275 FOR SALE BY KANSAS BLUE PRINT CO.


County Stafford State Kansas

Sec. 29 (Blk. Twp.) 23 (Sur. Rge.) 14W Map No.

Operator Natural Gas & Oil & Republic Nat.

Well No. 1 Farm Gilmore Est.

Elev. Location SW SE NE

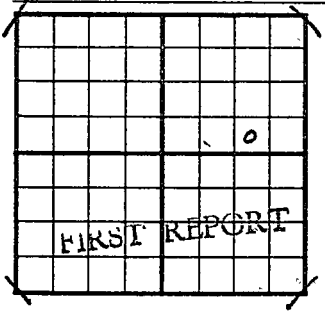

330 Ft. From S Line NE

990 Ft. From E Line Quarter

1st. Report JAN 20 1954

Completion

Remarks

Co tools

Spudding Date 1-15-54

Drlg. Data Wildcat

8" @ 212 drlg. 2035

J. G. McGEHEE

FORM 275 FOR SALE BY KANSAS BLUE PRINT CO.


County Stafford State Kansas

Sec. 29 (Blk. Twp.) 23 (Sur. Rge.) 14W Map No.

Operator Natural Gas & Oil & Republic Nat.

Well No. 1 Farm Gilmore Est.

Elev. 1966 Location SW SE NE

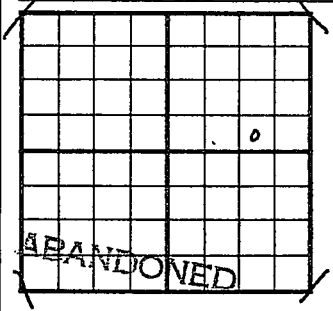

330 Ft. From S Line NE

990 Ft. From E Line Quarter

1st. Report

Completion FEB 3 1954

Remarks Wildcat

Co. tools

Spudding Date 1-15-54

Drlg. Data D & A TD 4167

8" @ 212 Anhy 875 Heeb. 3466

Br. lime 3603 Lans. 3613 DST 3789-3835

open 1 hr. Rec. 30' mud 800#

Simp. 4029 Arb. 4069 DST 4033-70

open 1 hr. Rec. 570' sul. wtr. 1275#

DST 4072-95 open 1 hr. Rec. 2940' sw

1450# TD 4167

D & A

J. G. McGEHEE