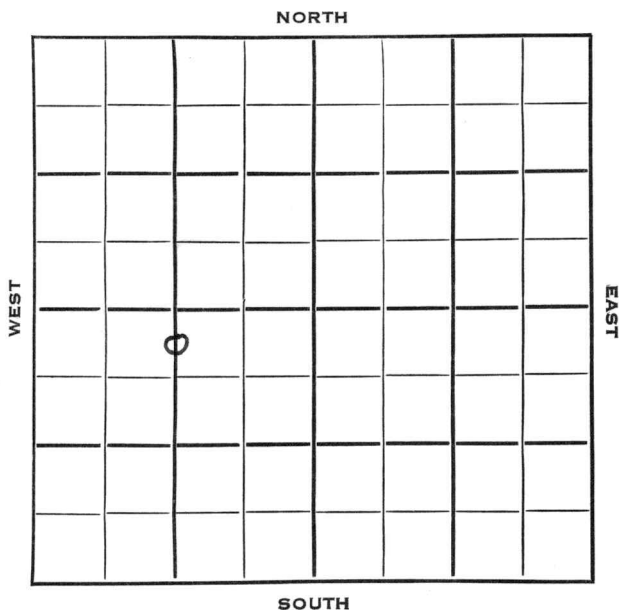


Section 29 Township 23 Range 33WWell No. 1 TemperoCompany Northern Pump

Finney KANSAS

SEC.	TWP.	R.
29	23	33W ✓

WELL NO.

1 Tempero

FARM

COMPANY

Northern Pump


CONTRACTOR

330 Ft. from N. Line

Ft. from S. Line

Ft. from E. Line

1320 Ft. from W. Line

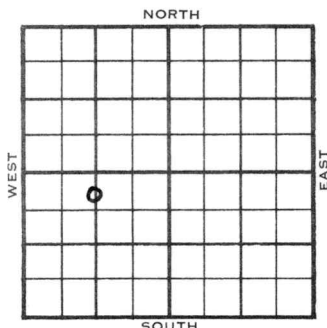

C N/2 N/2 SW

	ELEVATION	REPORT
1954	2907'	
1/27	Spud 1-23-54 10" @ 394' Drilg. 1150'	
2/3	Jeep Tops: Hol 2535', Her 2564', Kr. 2584', Win 2615' RTD 2620' 7" @ 2617'	
2/24	C.O.	
3/3	20/ 2595-99 25/ 2603-08 2000 A S/ 15 gwph 4 hrs. sq. C.O. 2583' 60/ 2556-68 100/ 2530-50 500 A Frac. 2000 A	
3/10	6/ 2610-11	
3/17	42/ 2566-80 45/ 2588-2604 frac. 5,893,000 gas.	
3/24	Spud 1-23-54 Gas well TD 2620 10" @ 394' Hol. 2535' Her. 2564' Kri. 2584' Win. 2615' TD 2620 7" @ 2617' CO to 2620 6/2610-11 42/2566-80 45/2589-2604 dol-frac. Comp. 7,200,000 gas 404#	

COMPLETED

County Finney State KansasSec. 29 (Blk.) 23 (Sur.) 33W Map No.Operator Northern PumpWell No. 1 Farm TemperoElev. Location C N $\frac{1}{2}$ N $\frac{1}{2}$ SW

FIRST REPORT							

330 Ft. From N Line SW1320 Ft. From W Line Quarter1st. Report JAN 27 1954

Completion

Remarks

Spudding Date 1-23-54

Drlg. Data

10" @ 394 drlg. 1150

County Finney State Kansas
 Sec. 29 (Blk.) 2 3 (Sur.) 33W Map No.
 Operator Northern Pump
 Well No. 1 Farm Tempero
 Elev. 2907 Location C N $\frac{1}{2}$ N $\frac{1}{2}$ SW



330 Ft. From N Line SW
1320 Ft. From W Line Quarter

1st. Report

Completion MAY 4 1954

Remarks

Spudding Date 1-23-54

Drlg. Data Gas well TD 2620

10" @ 394 Hol. 2535 Her. 2564

Kri. 2584 Win. 2615 TD 2620 7" @ 2617

C0 to 2620 6/ 2610-11 42/2566-80

45/ 2589-2604 dol-frac

Comp. 7,200,000 gas 404#

J. G. McGEHEE