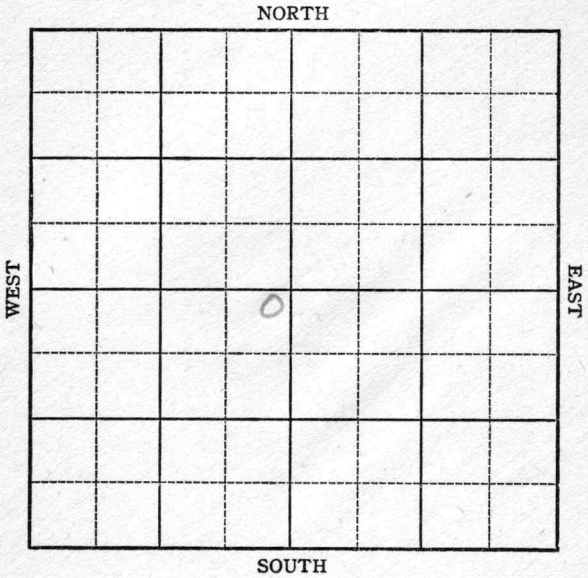


Section 29 Township 23 Range 34WWell No. 1 Garden City "C"Company Cities Service

KANSAS

Finney county

Sec. 29 Twp. 23 R. 34W

Well No. 1 Garden City "C" Farm
Cities Service Company


Hugoton Pool

100 Ft. from N. Line

 Ft. from S. Line

400 Ft. from E. Line

 Ft. from W. Line

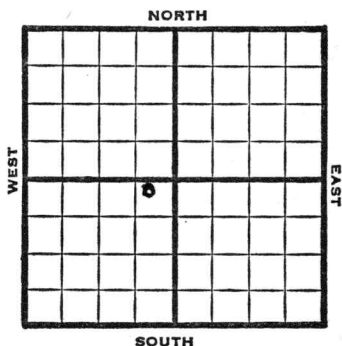

NE SW

1947 Elev 2971' REPORT

3/25	RUR
7/1	8" @ 760' Drlg 1430'
7/8	TD 2602' 5" @ 2601' RUST
7/16	100 shots 2534-54' 160 shots 2478-2510'
7/22	TD 2632 7500 acid
7/29	10,500 acid.
8/6	"
8/13	"
8/20	5" @ 2601' Perf 33,000 acid. 10,100,000 Gas R. Pr. 403# T.D. 2602' Completed

COMPLETED

Map No. _____ Sec. 29 Twp. 23 R. 34W

Well No. 1 Garden City "C"

Cities Service

Company

FIRST REPORT

Contractor

NE SW

SECTION PLAT

100 Ft. from N. Line

_____ Ft. from S. Line

400 Ft. from E. Line

_____ Ft. from W. Line

	0		

Finney County

Location _____

Rig up _____

Drilling and Remarks:

R U R

RECORD

Cased _____ in., _____ ft.

Sand _____

Gas _____

Oil _____

Total Depth _____

PRODUCTION

1st 24 hrs. Nat. _____

1st 24 hrs. after shot _____

Gas _____ Cu. Ft.

Dry Hole _____

Abandoned _____

Date

JUN 25 1947

19

S. J. LEWIS

Scout

Map No. _____ Sec. 29 Twp. 23 R. 34W

Well No. 1 Garden City "C"

_____ Cities Service _____ Company

COMPLETE

Contractor

NE SW

E12971
SECTION PLAT

100 Ft. from N. Line

_____ Ft. from S. Line

400 Ft. from E. Line

_____ Ft. from W. Line

	0		

Finney County

Location _____

Rig up _____

Drilling and Remarks:

5-102601

Ref.

33000 acial

10,100,000 Gas

40.2 # R B

RECORD

Cased _____ in., _____ ft.

Sand _____

Gas _____

Oil _____

Total Depth 2602

PRODUCTION

1st 24 hrs. Nat. _____

1st 24 hrs. after shot _____

Gas _____ Cu. Ft.

Dry Hole _____

Abandoned _____

Date

AUG 20 1947 19

S. J. LEWIS

Scout