

Kearny

KANSAS

Section 29 Township 23 Range 36W

Well No. 1 Foster "B"

Company Stanolind Oil and Gas Company

NORTH

				0			

WEST

EAST

SOUTH

Sec. 29 Twp. 23 R. 36W

Well No. #1 Foster "B" Farm

Stanolind Company

Contractor

Ft. from N. Line

150


Ft. from S. Line

Ft. from E. Line

150

Ft. from W. Line

SW NE

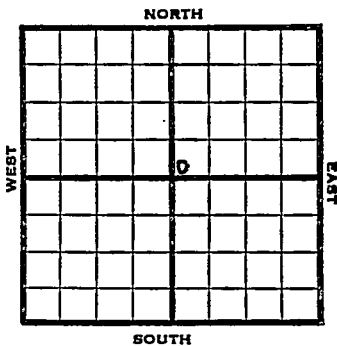

1952 Elev. 3230' REPORT

12/23 Spud 12-17-52
8" @ 768' WOC

12/25 WOC

1/1 Drlg. 2085

1/8 Ker 2596 Win 2649 Tow 2713 OP FT 2755
RTD 2770 5" @ 2755

1/22 Testing

1/28 Spud 12-17-52
Gas well TD 2780' 8" @ 768
Her. 2596' Win. 2649' Towanda 2713'
Ft. Riley 2755' TD 2770' 5" @ 2755
DD 2780' 18/2598-2601 42/2605-12
48/2617-25 78/2629-42 18/2651-54
36/2656-62 36/3668-74 54/2681-90
84/2714-28 36/2732-38 12/2740-42
18/2744-47 2500 A 17,500 A
Comp. 2,946,000 gas

COMPLETED

County Kearny State Kansas

Sec. 29 (Blk. Twp.) 23 (Sur. Rge.) 36W Map No.

Operator Stanolind

Well No. 1 Farm Foster "B"

Elev. 3230 Location SW NE

		0			

150 Ft. From S Line NE

150 Ft. From W Line Quarter

Ist. Report

Completion JAN ? 8 1953

Remarks

Spudding Date 12-17-52

Drig. Data Gas well TD 2780

8" @ 768 Her. 2596 Win. 2649

Towanda 2713 Ft. Riley 2755 TD 2770

5" @ 2755 DD 2780 18/ 2598-2601

42/ 2605-12 48/ 2617-25 78/ 2629-42

18/ 2651-54 36/ 2656-62 36/ 3668-74

54/ 2681-90 84/ 2714-28 36/ 2732-38

12/ 2740-42 18/ 2744-47 2500 A 17500 A

Comp. 2,946,000 gas.

J. G. McGEHEE