

KANSAS


Stafford

Form 51-5M-7-40-Palace

Section 29 Township 23 Range 11-W


Well No. #1 Ablen

Company Shell

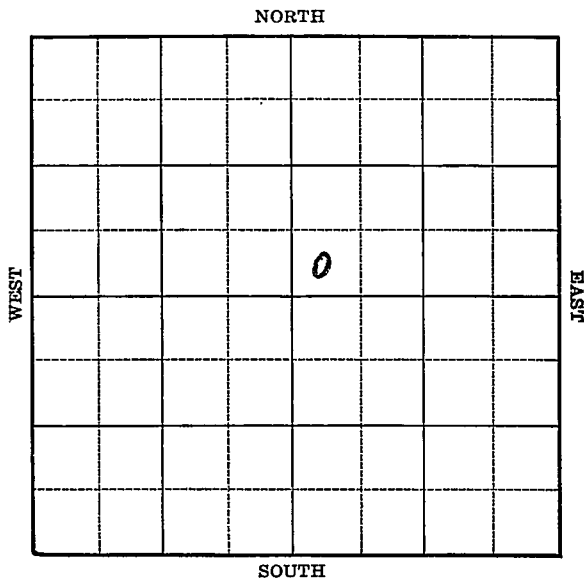

Sec. 29 Twp. 23 R. 11-WWell No. #1 Allen FarmShell Company

(Wildcat)

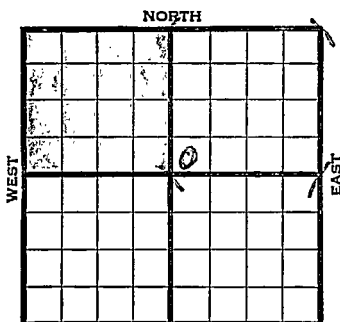 Ft. from N. Line330 Ft. from S. Line Ft. from E. Line330 Ft. from W. Line

Elev. 1820 (\$1000.00 Donation)

1940	REPORT
12/30	Location
1941	
1/9	8" - 295' Drlg. 2319'
1/13	Top Lansing 3323 3335
	Small show oil 3343-47
	Very small show 3371-76
	Dlg. 3406 (Tel)
Running ¹⁹ / ₂₇	lower on Lansing than Shell &
	Atlantic #1 Riley discovery well in SW/c
	Sec. 28-23-11W (Peabody)
1/16	Anhy. 566' Ft. Riley 1745'
	Florence 1853' Wreford 1955'
	Neva 2145' Topeka 2852'
	Lans. 3335 Drlg. 3440'
1/16	Top Viola 3651 Dlg. 3677(Shell)
Running 10' lower on Top Viola than Shell	
Atlantic #1 Riley in SW SW SW 28-23-11W a	
producer. (Frost)	
	OVER
	OVER

1941

1/17--Top Viola 3651 no show
Simpson shale 3702
Sandy dolomite 3718-20
Sandy dolomite 3722-30
No shows and no shows in Viola
Dlg. 3732 in Simpson shale
Expect Arbuckle around 3770 (Tel)

Running 10' lower on Viola than Shell-Atlantic
#1 Riley SW/c 28-23-11W (Frost)

1/18--Top Arbuckle 3758
Drilled to 3761--no show
Cored 3761-66 Recovered 2 feet porous
dolomite with sulphur odor T.D. 3766
Shut down waiting orders to see if they
want to run a Schlumberger (Tel)

1/18--Running 3' lower on Arbuckle than Shell-Atlantic
#1 Riley SW/c 28-23-11W. (Frost)

1/22 Viola 3651'
Arb. 3758'
T.D. 3766'
No shows.

ABANDONED

Map No. 47 Sec. 29 Twp. 23 R. 11WWell No. 1 AllenShell

Company


Contractor

FIRST REPORT

SW NE

 Ft. from N. Line330 Ft. from S. Line Ft. from E. Line330 Ft. from W. Line

SECTION PLAT

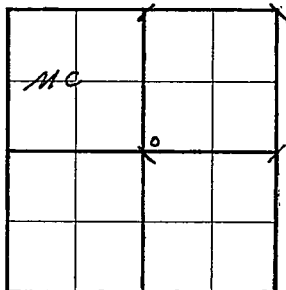

WILDCAT

Location X Rig up

Drilling and Remarks:

Special

RECORD

Cased in., ft.Sand Gas Oil Total Depth

PRODUCTION

1st 24 hrs. Nat. 1st 24 hrs. after shot Gas Cu. Ft.Dry Hole Abandoned

Date

DEC 30 1940 19

S. J. LEWIS Scout

Map No. 47 Sec. 29 Twp. 23 R. 11WWell No. 1 AllenShell

Company

Contractor

ABANDONED

SW NE

 Ft. from N. Line330 Ft. from S. Line Ft. from E. Line330 Ft. from W. Line

WILDCAT

SECTION PLAT

Location Rig up

Drilling and Remarks:

*Viola 3651**Cr 43758**No show*

RECORD

Cased in., ft.Sand Gas Oil Total Depth 3766

PRODUCTION

1st 24 hrs. Nat. 1st 24 hrs. after shot Gas Cu. Ft.Dry Hole Abandoned

Date

JAN 22 1941 ₁₉

S. J. LEWIS Scout