STATE OF KANSAS
STATE CORPORATION COMMISSION

Give All Information Completely
Make Required Affidavit
Mail or Deliver Report to:
Conservation Division
State Corporation Commission
800 Bitting Building
Wichita, Kansas

WELL PLUGGING RECORD
OR
FORMATION PLUGGING RECORD

Strike out upper line when reporting plugging off formations.

NORTH

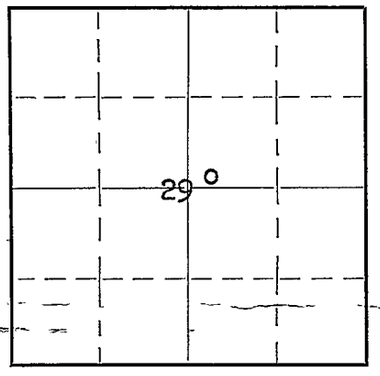

Locate well correctly on above Section Plat

STAFFORD County. Sec. 29 Twp. 23 Rge. (E) 11 (W)

Location as "NE¼NW¼SW¼" or footage from lines SW SW NE¼

Lease Owner SHELL OIL CO., INC.

Lease Name E. F. ALLEN Well No. 1

Office Address BOX 744, GREAT BEND, KANSAS

Character of Well (Completed as Oil, Gas or Dry Hole) DRY HOLE

Date well completed JANUARY 17 1941

Application for plugging filed JANUARY 20 1941

Application for plugging approved JANUARY 20 1941

Plugging Commenced JANUARY 18 1941

Plugging Completed JANUARY 18 1941

Reason for abandonment of well or producing formation DRY HOLE

If a producing well is abandoned, date of last production ~~193~~

Was permission obtained from the Conservation Division or its agents before plugging was commenced? YES

Name of Conservation Agent who supervised plugging of this well C. T. ALEXANDER

Producing formation ARBUCKLE DOLOMITE Depth to top 3758 Bottom Total Depth of Well 3766 Feet.

Show depth and thickness of all water, oil and gas formations.

OIL, GAS OR WATER RECORDS — CASING RECORD

Formation	Content	From	To	Size	Put In	Pulled Out
ARBUCKLE DOLOMITE	DRY	3758	3766	8 5/8"	287'	None

Describe in detail the manner in which the well was plugged, indicating where the mud fluid was placed and the method or methods used in introducing it into the hole. If cement or other plugs were used, state the character of same and depth placed, from ..... feet to ..... feet for each plug set.

FILLED HOLE WITH HEAVY MUD. SET WOOD PLUG
AT 287 FEET AND CAPPED WITH 15 SACKS CEMENT.
FILLED SURACE CASING WITH MUD WITHIN 14
FEET OF TOP AND CAPPED WITH 10 SACKS CEMENT.

(If additional description is necessary, use BACK of this sheet)

Correspondence regarding this well should be addressed to SHELL OIL CO., INC.

Address C/O W. M. GHOLSON, BOX 744, GREAT BEND, KANSAS

STATE OF KANSAS COUNTY OF BARTON, ss.

W. M. GHOLSON (employee of owner) ~~or owner or agent~~ of the above-described well, being first duly sworn on oath, says: That I have knowledge of the facts, statements, and matters herein contained and the log of the above-described well as filed and that the same are true and correct. So help me God.

(Signature) W. M. Gholson

BOX 744, GREAT BEND, KANSAS
(Address)

SUBSCRIBED AND SWORN TO before me this 26th day of JANUARY, 1941

Maxie M. Slayton
Notary Public.

My commission expires 12-1-44

17-6058 10-38—5M